

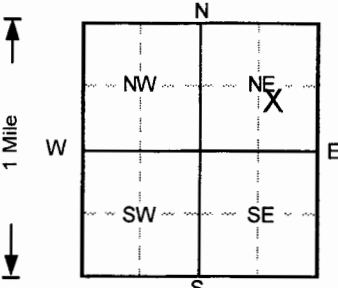
1 LOCATION OF WATER WELL: Fraction **NW 1/4 SE 1/4 NE 1/4** Section Number **27** Township Number **T 32 S** Range Number **R 4** **E/W**

County: **Cowley**

Distance and direction from nearest town or city street address of well if located within city?

NE corner of St. Mary's Cemetery prop. on 12th St.

2 WATER WELL OWNER: **Wilson's Quik Mart**
 RR#, St. Address, Box # : **1121 E 7th** Board of Agriculture, Division of Water Resources
 City, State, ZIP Code : **Winfield, Kansas 67156** Application Number:

3 LOCATE WELL'S LOCATION WITH AN "X" IN SECTION BOX:


4 DEPTH OF COMPLETED WELL: **13.5** ft. ELEVATION: **1164.01**

Depth(s) Groundwater Encountered: 1. ft. 2. ft. 3. ft.

WELL'S STATIC WATER LEVEL ft. below land surface measured on mo/day/yr

Pump test data: Well water was **NA** ft. after hours pumping gpm

Est. Yield **NA** gpm: Well water was ft. after hours pumping gpm

Bore Hole Diameter **8** in. to **13.5** ft., and in. to ft.

WELL WATER TO BE USED AS: 5 Public water supply 8 Air conditioning 11 Injection well
 1 Domestic 3 Feedlot 6 Oil field water supply 9 Dewatering 12 Other (Specify below)
 2 Irrigation 4 Industrial 7 Lawn and garden only **10** Monitoring well

Was a chemical/bacteriological sample submitted to Department? Yes No ; If yes, mo/day/yr sample was submitted

Water Well Disinfected? Yes No

5 TYPE OF BLANK CASING USED:

1 Steel 3 RMP (SR) 5 Wrought iron 8 Concrete tile CASING JOINTS: Glued Clamped
 2 **PVC** 4 ABS 6 Asbestos-Cement 9 Other (specify below) Welded
 7 Fiberglass Threaded

Blank casing diameter **2** in. to **5.5** ft., Dia in. to ft., Dia in. to ft.
 Casing height above land surface **-7.92** in., weight lbs./ft. Wall thickness or gauge No. **Sch. 40**

TYPE OF SCREEN OR PERFORATION MATERIAL **7** PVC 10 Asbestos-cement
 1 Steel 3 Stainless steel 5 Fiberglass 8 RMP (SR) 11 Other (specify)
 2 Brass 4 Galvanized steel 6 Concrete tile 9 ABS 12 None used (open hole)

SCREEN OR PERFORATION OPENINGS ARE: 5 Gauzed wrapped 8 Saw cut 11 None (open hole)
 1 Continuous slot **3** Mill slot 6 Wire wrapped 9 Drilled holes
 2 Louvered shutter 4 Key punched 7 Torch cut 10 Other (specify)

SCREEN-PERFORATED INTERVALS: From **5.5** ft. to **13.5** ft., From ft. to ft.
 From ft. to ft., From ft. to ft.

GRAVEL PACK INTERVALS: From **4** ft. to **13.5** ft., From ft. to ft.
 From ft. to ft., From ft. to ft.

6 GROUT MATERIAL: **1** Neat cement 2 Cement grout **3** Bentonite 4 Other

Grout Intervals: From **0** ft. to **1** ft., From **1** ft. to **4** ft., From ft. to ft.

What is the nearest source of possible contamination:
 1 Septic tank 4 Lateral lines 7 Pit privy 10 Livestock pens 14 Abandoned water well
 2 Sewer lines 5 Cess pool 8 Sewage lagoon 11 Fuel storage 15 Oil well/Gas well
 3 Watertight sewer lines 6 Seepage pit 9 Feedyard 12 Fertilizer storage 16 Other (specify below)
 13 Insecticide storage

Direction from well? How many feet?

FROM	TO	LITHOLOGIC LOG	FROM	TO	PLUGGING INTERVALS
0	1	Clay, silty, roots, Brown			
1	3	Clay, silty, moist, Dark Brown			
3	7	Clay, silty, moist, Brown			
7	10	Shale, v. firm, no odor, Green			
10	13.5	Limestone, hard, no odor, Tan			

		MW13 , Tag # 0042841 , Flushmount
		Project Name: Wilson Quick Mart - Monitoring
		GeoCore # 945 , KDHE # U2 018 00684

7 CONTRACTOR'S OR LANDOWNER'S CERTIFICATION: This water well was **1** constructed, (2) reconstructed, or (3) plugged under my jurisdiction and was completed on (mo/day/year) **9/16/2008** and this record is true to the best of my knowledge and belief.

Kansas Water Well Contractor's License No. **527** This Water Well Record was completed on (mo/day/yr) **10/6/2008** under the business name of **GeoCore, Inc.** by (signature) *Dale Adell*

OFFICE USE ONLY
T
R
EM
SEC.