


1 LOCATION OF WATER WELL: Fraction SE NE NE Section Number 4 Township Number T 32 S Range Number R 4 E
 County: Cowley

Distance and direction from nearest town or city street address of well if located within city?
3 miles north of Winfield

2 WATER WELL OWNER: Shane McPherson
 RR#, St. Address, Box #: Rt. 1 Box 269C Board of Agriculture, Division of Water Resources
 City, State, ZIP Code: Winfield KS 67156 Application Number:

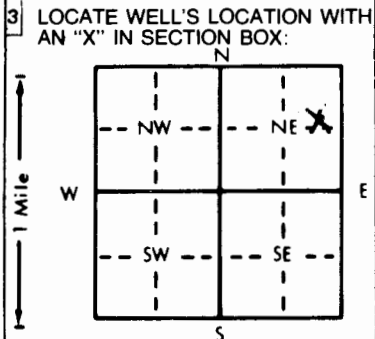

4 DEPTH OF COMPLETED WELL: 140 ft. ELEVATION:
 Depth(s) Groundwater Encountered 1. 85' ft. 2. ft. 3. ft.
 WELL'S STATIC WATER LEVEL 40' ft. below land surface measured on mo/day/yr
 Pump test data: Well water was ft. after hours pumping 7 gpm
 Est. Yield 9 gpm Well water was ft. after hours pumping gpm
 Bore Hole Diameter: 8 3/4 in. to 140' ft., and in. to ft.
 WELL WATER TO BE USED AS:
 1 Domestic 2 Irrigation 3 Feedlot 4 Industrial 5 Public water supply 6 Oil field water supply 7 Lawn and garden only 8 Air conditioning 9 Dewatering 10 Monitoring well 11 Injection well 12 Other (Specify below)
 Was a chemical/bacteriological sample submitted to Department? Yes No If yes, mo/day/yr sample was submitted
 Water Well Disinfected? Yes No

5 TYPE OF BLANK CASING USED:
 1 Steel 2 PVC 3 RMP (SR) 4 ABS 5 Wrought iron 6 Asbestos-Cement 7 Fiberglass 8 Concrete tile 9 Other (specify below)
 Blank casing diameter 5 in. to 80' ft., Dia. in. to ft., Dia. in. to ft.
 Casing height above land surface 18" in., weight lbs./ft. Wall thickness or gauge No.
 TYPE OF SCREEN OR PERFORATION MATERIAL:
 1 Steel 2 Brass 3 Stainless steel 4 Galvanized steel 5 Fiberglass 6 Concrete tile 7 PVC 8 RMP (SR) 9 ABS 10 Asbestos-cement 11 Other (specify) 12 None used (open hole)
 SCREEN OR PERFORATION OPENINGS ARE:
 1 Continuous slot 2 Louvered shutter 3 Mill slot 4 Key punched 5 Gauzed wrapped 6 Wire wrapped 7 Torch cut 8 Saw cut 9 Drilled holes 10 Other (specify) 11 None (open hole)
 SCREEN-PERFORATED INTERVALS: From 80' ft. to 100' ft., From ft. to ft., From ft. to ft., From ft. to ft.
 GRAVEL PACK INTERVALS: From 20 ft. to 140 ft., From ft. to ft., From ft. to ft., From ft. to ft.

6 GROUT MATERIAL: 1 Neat cement 2 Cement grout 3 Bentonite 4 Other
 Grout Intervals: From 0 ft. to 20 ft., From ft. to ft., From ft. to ft., From ft. to ft.
 What is the nearest source of possible contamination:
 1 Septic tank 2 Sewer lines 3 Watertight sewer lines 4 Lateral lines 5 Cess pool 6 Seepage pit 7 Pit privy 8 Sewage lagoon 9 Feedyard 10 Livestock pens 11 Fuel storage 12 Fertilizer storage 13 Insecticide storage 14 Abandoned water well 15 Oil well/Gas well 16 Other (specify below)
 Direction from well? How many feet?

FROM	TO	LITHOLOGIC LOG	FROM	TO	PLUGGING INTERVALS
<u>0</u>	<u>1</u>	<u>Dirt</u>			
<u>1</u>	<u>3</u>	<u>clay</u>			
<u>3</u>	<u>6</u>	<u>soft lime</u>			
<u>6</u>	<u>83</u>	<u>Shale</u>			
<u>83</u>	<u>85</u>	<u>sandy lime</u>			
<u>85</u>	<u>140</u>	<u>shale & lime</u>			

7 CONTRACTOR'S OR LANDOWNER'S CERTIFICATION: This water well was constructed, reconstructed, or plugged under my jurisdiction and was completed on (mo/day/year) and this record is true to the best of my knowledge and belief. Kansas Water Well Contractor's License No. 625 This Water Well Record was completed on (mo/day/yr) 6-26-98 under the business name of McPherson Drilling by (signature) Billy E McPherson

OFFICE USE ONLY
T
R
EM
SEC.
1/4
1/4
1/4