


WATER WELL RECORD Form WWC-5 KSA 82a-1212

1 LOCATION OF WATER WELL: Fraction SE 1/4 NW 1/4 NE 1/4 Section Number 27 Township Number T 32 S Range Number R 4 EW

Distance and direction from nearest town or city street address of well if located within city? 1902 E. 9th - Winfield, KS

2 WATER WELL OWNER: Wilson's Quik Mart RR#, St. Address, Box #: 1705 Manor Board of Agriculture, Division of Water Resources City, State, ZIP Code: Winfield, Kansas 67156 Application Number:

3 LOCATE WELL'S LOCATION WITH AN "X" IN SECTION BOX:

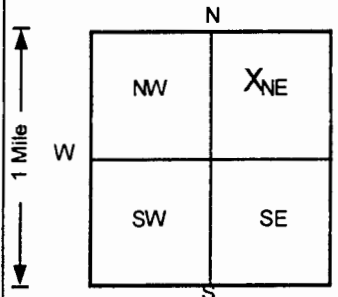

4 DEPTH OF COMPLETED WELL 13 ft ELEVATION: 1179.59 Depth(s) Groundwater Encountered 1. 10 ft 2. ft 3. ft WELL'S STATIC WATER LEVEL 7.05 ft below land surface measured on mo/day/yr 7/1/98 Pump test data: Well water was NA ft after hours pumping gpm Est. Yield NA gpm Well water was ft after hours pumping gpm Bore Hole Diameter 8 in. to 13 ft, and in. to ft WELL WATER TO BE USED AS: 5 Public water supply 8 Air conditioning 11 Injection well 1 Domestic 3 Feedlot 6 Oil field water supply 9 Dewatering 12 Other (Specify below) 2 Irrigation 4 Industrial 7 Lawn and garden only 10 Monitoring well Was a chemical/bacteriological sample submitted to Department? Yes.....No [checked]; If yes, mo/day/yr sample was submitted Water Well Disinfected? Yes No [checked]

5 TYPE OF BLANK CASING USED: 1 Steel 3 RMP (SR) 5 Wrought iron 8 Concrete tile CASING JOINTS: Glued Clamped 2 PVC 4 ABS 6 Asbestos-Cement 9 Other (specify below) Welded 7 Fiberglass Threaded. [checked]

Blank casing diameter 2 in. to 3 ft, Dia in. to ft, Dia in. to ft. Casing height above land surface -2.52 in., weight lbs./ft. Wall thickness or gauge No. Sch. 40

TYPE OF SCREEN OR PERFORATION MATERIAL 1 Steel 3 Stainless steel 5 Fiberglass 7 PVC 10 Asbestos-cement 2 Brass 4 Galvanized steel 6 Concrete tile 8 RMP (SR) 11 Other (specify) 12 None used (open hole)

SCREEN OR PERFORATION OPENINGS ARE: 1 Continuous slot 3 Mill slot 5 Gauzed wrapped 8 Saw cut 11 None (open hole) 2 Louvered shutter 4 Key punched 6 Wire wrapped 9 Drilled holes 10 Other (specify) 7 Torch cut

SCREEN-PERFORATED INTERVALS: From 3 ft to 13 ft, From ft to ft From ft to ft, From ft to ft GRAVEL PACK INTERVALS: From 2.5 ft to 13 ft, From ft to ft From ft to ft, From ft to ft

6 GROUT MATERIAL: 1 Neat cement 2 Cement grout 3 Bentonite 4 Other Grout Intervals: From 0 ft to 1.5 ft, From 1.5 ft to 2.5 ft, From ft to ft

What is the nearest source of possible contamination: 1 Septic tank 4 Lateral lines 7 Pit privy 10 Livestock pens 14 Abandoned water well 2 Sewer lines 5 Cess pool 8 Sewage lagoon 11 Fuel storage 15 Oil well/Gas well 3 Watertight sewer lines 6 Seepage pit 9 Feedyard 12 Fertilizer storage 16 Other (specify below) UST: Basin Direction from well? East How many feet? 80

Table with columns FROM, TO, LITHOLOGIC LOG, FROM, TO, PLUGGING INTERVALS. Data includes: 0-0.5 Concrete, 0.5-7 Clay, Very Dark Brown, 7-13 Clay, Medium Green. Also includes MW3, Tag # 00116769, Flushmount, Project Name: Wilson's Quik Mart, Inc., GeoCore # 136, KDHE # U2 018 684

7 CONTRACTOR'S OR LANDOWNER'S CERTIFICATION: This water well was (1) constructed, (2) reconstructed, or (3) plugged under my jurisdiction and was completed on (mo/day/year) 8/17/95 and this record is true to the best of my knowledge and belief. Kansas Water Well Contractor's License No. 527. This Water Well Record was completed on (mo/day/yr) 7/29/98. under the business name of GeoCore Services, Inc. by (signature)

OFFICE USE ONLY T R EW SEC 1/2 1/2 1/2