


WATER WELL RECORD Form WWC-5 KSA 82a-1212

1 LOCATION OF WATER WELL: County: Cowley Fraction NE 1/4 SW 1/4 NE 1/4 Section Number 27 Township Number T 32 S Range Number R 4 EW

Distance and direction from nearest town or city street address of well if located within city? 1902 E. 9th - Winfield, KS

2 WATER WELL OWNER: Wilson's Quik Mart RR#, St. Address, Box #: 1705 Manor City, State, ZIP Code: Winfield, Kansas 67156 Board of Agriculture, Division of Water Resources Application Number:

3 LOCATE WELL'S LOCATION WITH AN "X" IN SECTION BOX:

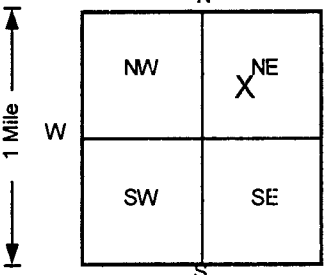

4 DEPTH OF COMPLETED WELL: 13 ft ELEVATION: 1176.92 Depth(s) Groundwater Encountered 1 ft 2 ft 3 ft WELL'S STATIC WATER LEVEL: 5.88 ft below land surface measured on mo/day/yr 7/1/98 Pump test data: Well water was N.A. ft after hours pumping gpm Est Yield: N.A. gpm: Well water was ft after hours pumping gpm Bore Hole Diameter: 8 in. to 13 ft, and in. to ft WELL WATER TO BE USED AS: 5 Public water supply 8 Air conditioning 11 Injection well 1 Domestic 3 Feedlot 6 Oil field water supply 9 Dewatering 12 Other (Specify below) 2 Irrigation 4 Industrial 7 Lawn and garden only 10 Monitoring well Was a chemical/bacteriological sample submitted to Department? Yes.....No [checked]; If yes, mo/day/yr sample was submitted Water Well Disinfected? Yes No [checked]

5 TYPE OF BLANK CASING USED: 1 Steel 2 PVC [checked] 3 RMP (SR) 4 ABS 5 Wrought iron 6 Asbestos-Cement 7 Fiberglass 8 Concrete tile 9 Other (specify below) CASING JOINTS: Glued Clamped Welded Threaded [checked] Blank casing diameter: 2 in. to 3 ft, Dia in. to ft, Dia in. to ft Casing height above land surface: -5.88 in., weight Sch 40 lbs./ft. Wall thickness or gauge No.

TYPE OF SCREEN OR PERFORATION MATERIAL: 1 Steel 2 Brass 3 Stainless steel 4 Galvanized steel 5 Fiberglass 6 Concrete tile 7 PVC [checked] 8 RMP (SR) 9 ABS 10 Asbestos-cement 11 Other (specify) 12 None used (open hole) SCREEN OR PERFORATION OPENINGS ARE: 1 Continuous slot 2 Louvered shutter 3 Mill slot [checked] 4 Key punched 5 Gauzed wrapped 6 Wire wrapped 7 Torch cut 8 Saw cut 9 Drilled holes 11 None (open hole) 10 Other (specify)

SCREEN-PERFORATED INTERVALS: From 3 ft to 13 ft, From ft to ft, From ft to ft GRAVEL PACK INTERVALS: From 2 ft to 13 ft, From ft to ft, From ft to ft

6 GROUT MATERIAL: 1 Neat cement 2 Cement grout [checked] 3 Bentonite 4 Other Grout intervals: From 0 ft to 1 ft, From 1 ft to 2 ft, From ft to ft What is the nearest source of possible contamination: 1 Septic tank 2 Sewer lines 3 Watertight sewer lines 4 Lateral lines 5 Cess pool 6 Seepage pit 7 Pit privy 8 Sewage lagoon 9 Feedyard 10 Livestock pens 11 Fuel storage 12 Fertilizer storage 13 Insecticide storage 14 Abandoned water well 15 Oil well/Gas well 16 Other (specify below) UST Basin [checked] Direction from well? Northeast How many feet? 280

Table with columns: FROM, TO, LITHOLOGIC LOG, FROM, TO, PLUGGING INTERVALS. Rows include: 0-3 Clay, Light Brown; 3-8 Clay, Brown; 8-13 Clay, Light Green; MW7, Tag # 00264255, Flushmount; Project Name: Wilson's Quik Mart, Inc.; GeoCore # 136, KDHE # U2 018 684

7 CONTRACTOR'S OR LANDOWNER'S CERTIFICATION: This water well was (1) constructed, (2) reconstructed, or (3) plugged under my jurisdiction and was completed on (mo/day/year) 6/29/98 and this record is true to the best of my knowledge and belief. Kansas Water Well Contractor's License No. 527 This Water Well Record was completed on (mo/day/yr) 7/29/98 under the business name of GeoCore Services, Inc. by (signature)