


WATER WELL RECORD Form WWC-5 KSA 82a-1212

1 LOCATION OF WATER WELL: Fraction NW 1/4 SE 1/4 NE 1/4 Section Number 28 Township Number T 32 S Range Number R 4 EW
 County: Cowley
 Distance and direction from nearest town or city street address of well if located within city?
519 E 9th; Winfield, KS

2 WATER WELL OWNER: R.L. Baker
 RR#, St. Address, Box #: 53 West Bourough Rd. Board of Agriculture, Division of Water Resources
 City, State, ZIP Code: Wellington, KS 67152 Application Number:

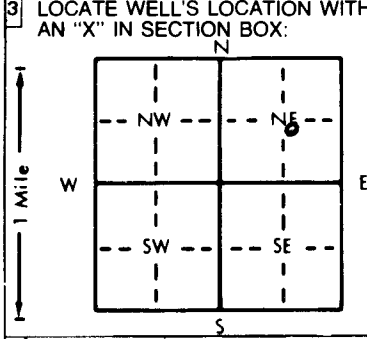

4 DEPTH OF COMPLETED WELL: 20' ft. ELEVATION:
 Depth(s) Groundwater Encountered 1 13.5 ft. 2. ft. 3. ft.
 WELL'S STATIC WATER LEVEL 11.30 ft. below land surface measured on mo/day/yr 4-14-98
 Pump test data: Well water was ft. after hours pumping gpm
 Est. Yield gpm: Well water was ft. after hours pumping gpm
 Bore Hole Diameter: 8 1/2' in. to 20' ft., and in. to ft.
 WELL WATER TO BE USED AS: 5 Public water supply 8 Air conditioning 11 Injection well
 1 Domestic 3 Feedlot 6 Oil field water supply 9 Dewatering 12 Other (Specify below)
 2 Irrigation 4 Industrial 7 Lawn and garden only 10 Monitoring well
 Was a chemical/bacteriological sample submitted to Department? Yes No X ; If yes, mo/day/yr sample was submitted
 Water Well Disinfected? Yes No

5 TYPE OF BLANK CASING USED: 1 Steel 3 RMP (SR) 5 Wrought iron 8 Concrete tile CASING JOINTS: Glued Clamped
2 PVC 4 ABS 6 Asbestos-Cement 9 Other (specify below) Welded X
 Blank casing diameter 2.375 in. to 10' ft., Dia in. to ft., Dia in. to SDR 13 ft.
 Casing height above land surface Flush Mt. in., weight lbs./ft. Wall thickness or gauge No. SCH 40
 TYPE OF SCREEN OR PERFORATION MATERIAL: 7 PVC 10 Asbestos-cement
 1 Steel 3 Stainless steel 5 Fiberglass 8 RMP (SR) 11 Other (specify)
 2 Brass 4 Galvanized steel 6 Concrete tile 9 ABS 12 None used (open hole)
 SCREEN OR PERFORATION OPENINGS ARE: 5 Gauzed wrapped 8 Saw cut 11 None (open hole)
 1 Continuous slot 3 Mill slot 6 Wire wrapped 9 Drilled holes
 2 Louvered shutter 4 Key punched 7 Torch cut 10 Other (specify)
 SCREEN-PERFORATED INTERVALS: From 20' ft. to 10' ft., From ft. to ft.
 From ft. to ft., From ft. to ft.
 GRAVEL PACK INTERVALS: From 20' ft. to 8' ft., From ft. to ft.
 From ft. to ft., From ft. to ft.

6 GROUT MATERIAL: 1 Neat cement 2 Cement grout 3 Bentonite 4 Other
 Grout Intervals: From 8' to 3' ft., From 3' to 0' ft., From ft. to ft.
 What is the nearest source of possible contamination:
 1 Septic tank 4 Lateral lines 7 Pit privy 11 Fuel storage 14 Abandoned water well
 2 Sewer lines 5 Cess pool 8 Sewage lagoon 12 Fertilizer storage 15 Oil well/Gas well
 3 Watertight sewer lines 6 Seepage pit 9 Feedyard 13 Insecticide storage 16 Other (specify below)

Direction from well? How many feet?

FROM	TO	LITHOLOGIC LOG	FROM	TO	PLUGGING INTERVALS
0	.5	Concrete			
.5	8.5	Dk brn-black clay to silty clay, moist no odor, firm to stiff, med plasticity			
8.5	13	Yellow brn clay w/gray brn clay mottling stiff, no odor oxide staining, moist Slight odor, moist, trace amt. of sand			
13	20	Tan Brn clayey sand to sand fine-med grained, no odor, well graded, subrounded sand wet			

F.M. OK'd by Don Taylor

7 CONTRACTOR'S OR LANDOWNER'S CERTIFICATION: This water well was (1) constructed, (2) reconstructed, or (3) plugged under my jurisdiction and was completed on (mo/day/year) 4-13-98 and this record is true to the best of my knowledge and belief. Kansas Water Well Contractor's License No. 539 This Water Well Record was completed on (mo/day/yr) 4-15-98 under the business name of JB Environmental by (signature) James Bieker

OFFICE USE ONLY
T
R
EW
SEC.
1/4
1/4
1/4