

CORRECTION(S) TO WATER WELL RECORD (WWC-5)

(to rectify lacking or incorrect information)

County: Cowley

Location listed as:

Location changed to:

Section-Township-Range: 30-26S-2E

22-32S-4E

Fraction ($\frac{1}{4}$ $\frac{1}{4}$ $\frac{1}{4}$): SW SW SW

C NE SW

Other changes: Initial statements: _____

Changed to: _____

Comments: _____

verification method: well site address, city street map, and mapping tool & aerial photos on KGS website.

initials: DRA date: 7/16/2012

submitted by: Kansas Geological Survey, Data Resources Library, 1930 Constant Ave., Lawrence, KS 66047-3726
to: Kansas Dept of Health & Environment, Bureau of Water, 1000 SW Jackson, Suite 420, Topeka, KS 66612-1367.


MW 3

1 LOCATION OF WATER WELL: Fraction SW 1/4 SW 1/4 SW 1/4 Section Number 30 Township Number T 26 S Range Number R 2 EW
 County: Cowley

Distance and direction from nearest town or city street address of well if located within city?
Former Winfield Bus Service 1421 Olive, Winfield, Kansas 67156

2 WATER WELL OWNER:
 RR#, St. Address, Box # Former Winfield Bus Service Attn: Donald Drum Board of Agriculture, Division of Water Resources
 City, State, ZIP Code 1203 E. 8th Winfield, Kansas 67156 Application Number: -----

3 LOCATE WELL'S LOCATION WITH AN "X" IN SECTION BOX:

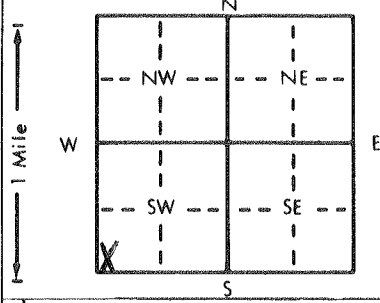

4 DEPTH OF COMPLETED WELL: 15 ft. ELEVATION: -----
 Depth(s) Groundwater Encountered 1. 6.3 ft. 2. ----- ft. 3. ----- ft.
 WELL'S STATIC WATER LEVEL 14.46 ft. below land surface measured on mo/day/yr 4/12/95
 Pump test data: Well water was ----- ft. after ----- hours pumping ----- gpm
 Est. Yield ----- gpm: Well water was ----- ft. after ----- hours pumping ----- gpm
 Bore Hole Diameter 8.625 in. to 15 ft., and ----- in. to ----- ft.
 WELL WATER TO BE USED AS:
 5 Public water supply 8 Air conditioning 11 Injection well
 1 Domestic 3 Feedlot 6 Oil field water supply 9 Dewatering 12 Other (Specify below)
 2 Irrigation 4 Industrial 7 Lawn and garden only 10 Monitoring well MW-3
 Was a chemical/bacteriological sample submitted to Department? Yes ----- No X; If yes, mo/day/yr sample was submitted -----
 Water Well Disinfected? Yes ----- No X

5 TYPE OF BLANK CASING USED:
 1 Steel 3 RMP (SR) 5 Wrought iron 8 Concrete tile CASING JOINTS: Glued ----- Clamped -----
2 PVC 4 ABS 6 Asbestos-Cement 9 Other (specify below) Welded -----
 7 Fiberglass Threaded X

Blank casing diameter 2 in. to 5 ft., Dia. ----- in. to ----- ft., Dia. ----- in. to ----- ft.
 Casing height above land surface 0 in., weight SCH 40 PVC lbs./ft. Wall thickness or gauge No. -----

TYPE OF SCREEN OR PERFORATION MATERIAL:
 1 Steel 3 Stainless steel 5 Fiberglass 8 RMP (SR) 10 Asbestos-cement
 2 Brass 4 Galvanized steel 6 Concrete tile 9 ABS 11 Other (specify) -----
 12 None used (open hole)

SCREEN OR PERFORATION OPENINGS ARE:
 1 Continuous slot 3 Mill slot 5 Gauzed wrapped 8 Saw cut 11 None (open hole)
 2 Louvered shutter 4 Key punched 6 Wire wrapped 9 Drilled holes
 7 Torch cut 10 Other (specify) -----

SCREEN-PERFORATED INTERVALS: From 5 ft. to 15 ft., From ----- ft. to ----- ft., From ----- ft. to ----- ft.
 SAND GRAVEL PACK INTERVALS: From 4 ft. to 15 ft., From ----- ft. to ----- ft., From ----- ft. to ----- ft.

6 GROUT MATERIAL: 1 Neat cement 2 Cement grout 3 Bentonite 4 Other -----
 Grout Intervals: From 0 ft. to 2 ft., From 2 ft. to 4 ft., From ----- ft. to ----- ft.

What is the nearest source of possible contamination:
 1 Septic tank 4 Lateral lines 7 Pit privy 10 Livestock pens 14 Abandoned water well
 2 Sewer lines 5 Cess pool 8 Sewage lagoon 11 Fuel storage 15 Oil well/Gas well
 3 Watertight sewer lines 6 Seepage pit 9 Feedyard 12 Fertilizer storage 16 Other (specify below)
 Direction from well? ----- How many feet? Contaminated site

FROM	TO	LITHOLOGIC LOG	FROM	TO	PLUGGING INTERVALS
GL	0.50	Concrete			Flush Mount Wai
0.50	4.00	Silty Clay			Don Taylor
4.00	6.00	Shale			4/3/95
6.00	15.00	Limestone			
15.00	TD	End of Borehole			

7 CONTRACTOR'S OR LANDOWNER'S CERTIFICATION: This water well was (1) constructed, (2) reconstructed, or (3) plugged under my jurisdiction and was completed on (mo/day/year) 4/11/95 and this record is true to the best of my knowledge and belief. Kansas Water Well Contractor's License No. 585 This Water Well Record was completed on (mo/day/yr) 4/17/95 under the business name of Associated Environmental, Inc. by (signature) [Signature]