


1 LOCATION OF WATER WELL: Fraction SW 1/4 SE 1/4 SW 1/4 Section Number 21 Township Number T 32 S Range Number R 4 E/V

Distance and direction from nearest town or city street address of well if located within city? 405 Manning, Winfield

2 WATER WELL OWNER: Winfield Farmers Union Coop RR#, St. Address, Box # : P.O. Box 536 Board of Agriculture, Division of Water Resources City, State, ZIP Code : Winfield, Kansas 67156 Application Number:

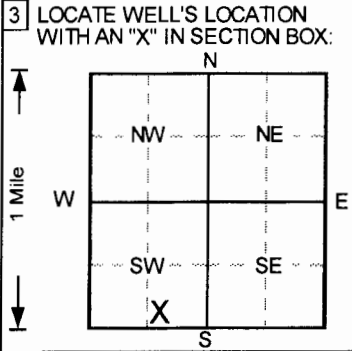

3 LOCATE WELL'S LOCATION WITH AN "X" IN SECTION BOX: 4 DEPTH OF COMPLETED WELL 21 ft ELEVATION: 1122.26 Depth(s) Groundwater Encountered 1. ft 2. ft 3. ft WELL'S STATIC WATER LEVEL 15.85 ft below land surface measured on mo/day/yr 3/25/2013 Pump test data: Well water was NA ft after hours pumping gpm Est. Yield NA gpm Well water was ft after hours pumping gpm Bore Hole Diameter 8 in. to 21.2 ft, and in. to ft WELL WATER TO BE USED AS: 5 Public water supply 8 Air conditioning 11 Injection well 1 Domestic 3 Feedlot 6 Oil field water supply 9 Dewatering 12 Other (Specify below) 2 Irrigation 4 Industrial 7 Lawn and garden only 10 Monitoring Well Was a chemical/bacteriological sample submitted to Department? Yes No ; If yes, mo/day/yr sample was submitted Water Well Disinfected? Yes No

5 TYPE OF BLANK CASING USED: 1 Steel 3 RMP (SR) 5 Wrought iron 8 Concrete tile CASING JOINTS: Glued Clamped 2 PVC 4 ABS 6 Asbestos-Cement 9 Other (specify below) Welded Threaded Blank casing diameter 2 in. to 10 ft, Dia. in. to ft, Dia. in. to ft Casing height above land surface -6.84 in., weight lbs./ft. Wall thickness or gauge No. Sch. 40 TYPE OF SCREEN OR PERFORATION MATERIAL 1 Steel 3 Stainless steel 5 Fiberglass 7 PVC 10 Asbestos-cement 2 Brass 4 Galvanized steel 6 Concrete tile 8 RMP (SR) 11 Other (specify) 12 None used (open hole)

SCREEN OR PERFORATION OPENINGS ARE: 1 Continuous slot 2 Louvered shutter 3 Mill slot 4 Key punched 5 Gauzed wrapped 6 Wire wrapped 7 Torch cut 8 Saw cut 11 None (open hole) 9 Drilled holes 10 Other (specify) SCREEN-PERFORATED INTERVALS: From 10 ft to 21 ft, From ft to ft, From ft to ft GRAVEL PACK INTERVALS: From 8 ft to 21.2 ft, From ft to ft, From ft to ft

6 GROUT MATERIAL: 1 Neat cement 2 Cement grout 3 Bentonite 4 Other Concrete Grout intervals: From 0 ft to 2 ft, From 2 ft to 8 ft, From ft to ft What is the nearest source of possible contamination: 1 Septic tank 4 Lateral lines 7 Pit privy 10 Livestock pens 14 Abandoned water well 2 Sewer lines 5 Cess pool 8 Sewage lagoon 11 Fuel storage 15 Oil well/Gas well 3 Watertight sewer lines 6 Seepage pit 9 Feedyard 12 Fertilizer storage 16 Other (specify below) 13 Insecticide storage Direction from well? How many feet?

LITHOLOGIC LOG and PLUGGING INTERVALS table with columns FROM, TO, LITHOLOGIC LOG, FROM, TO, PLUGGING INTERVALS. Log entries include Fill - Rock and clay, Clay, silty, Dark Brown, Clay, silty, sandy, Brown, black mottling, Clay, silty, v. sandy (vf), Brown, Rock frags w/clay matrix, Clay, silty, sandy, rock frags., Tan, Shale, limestone lenses, Tan.

7 CONTRACTOR'S OR LANDOWNER'S CERTIFICATION: This water well was 1 constructed, 2 reconstructed, or 3 plugged under my jurisdiction and was completed on (mo/day/year) 3/21/2013 and this record is true to the best of my knowledge and belief. Kansas Water Well Contractor's License No. 527 This Water Well Record was completed on (mo/day/yr) 4/2/2013 under the business name of GeoCore, Inc. by (signature) Dale

OFFICE USE ONLY T R FM SEC 1/4 1/4