

WATER WELL PLUGGING RECORD Form WWC-5P

KSA 82a-1212 ID NO.


MW-09

| | | | | |
|-----------------------------------------------------------|------------------------------------------|--------------------------|-------------------------------|----------------------------------------------------------------------------------------|
| 1 LOCATION OF WATER WELL: County: <u>Cowley</u> | Fraction <u>1/4 SW 1/4 SE 1/4 SE 1/4</u> | Section Number <u>27</u> | Township Number T <u>32</u> S | Range Number <u>4</u> <input checked="" type="checkbox"/> E <input type="checkbox"/> W |
|-----------------------------------------------------------|------------------------------------------|--------------------------|-------------------------------|----------------------------------------------------------------------------------------|

Street/Rural Address of Well Location; if unknown, distance & direction from nearest town or intersection: If at owner's address, check here 2000 Liquitex Lane Winfield KS 67156

Global Positioning Systems (GPS) information:
 Latitude: 37.23161 (in decimal degrees)
 Longitude: -96.97367 (in decimal degrees)
 Elevation: _____
 Horizontal Datum: WGS84, NAD83, NAD27
 Collection Method: _____

2 WATER WELL OWNER: Crayola LLC (Binney & Smith) GPS unit (Make/Model: Garmin etrek)
 RR#, St. Address, Box #: 1100 Church Lane Digital Map/Photo, Topographic Map, Land Survey
 City, State ZIP Code: Easton PA 18044-0431 Est. Accuracy: < 3 m, 3-5 m, 5-15 m, > 15 m

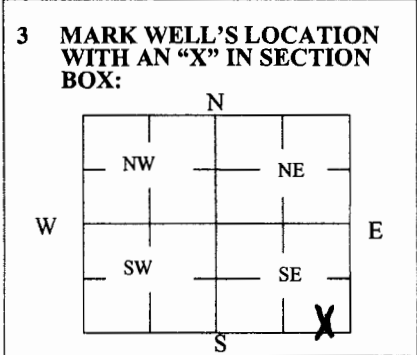

4 DEPTH OF WELL 23 ft.
 WELL'S STATIC WATER LEVEL _____ ft.
 WELL WAS USED AS:
 Domestic Public Water Supply Dewatering
 Irrigation Oil Field Water Supply Monitoring
 Feedlot Domestic (Lawn & Garden) Injection Well
 Industrial Air Conditioning Other _____
 Was a chemical/bacteriological sample submitted to Department? Yes No

5 TYPE OF BLANK CASING USED:

Steel RMP (SR) Wrought Fiberglass Other (Specify below) _____
 PVC ABS Asbestos-Cement Concrete Tile _____

Blank casing diameter 2 in. Was casing pulled? Yes No If yes, how much all
 Casing height above or below land surface -6 in.

6 GROUT PLUG MATERIAL: Neat cement Cement grout Bentonite Other _____

Grout Plug Intervals: From 3 ft. to 23 ft., From — ft. to — ft., From — ft. to — ft.



What is the nearest source of possible contamination:
 Septic tank Seepage pit Fuel storage Other (specify below) _____
 Sewer lines Pit privy Fertilizer storage _____
 Watertight sewer lines Sewage lagoon Insecticide storage _____
 Lateral lines Feedyard Abandoned water well Direction from well? _____
 Cess pool Livestock pens Oil well/Gas well How many feet? _____

| FROM | TO | PLUGGING MATERIALS | FROM | TO | PLUGGING MATERIALS |
|----------|-----------|--------------------|------|----|--------------------|
| <u>0</u> | <u>3</u> | <u>Top soil</u> | | | |
| <u>3</u> | <u>23</u> | <u>Bentonite</u> | | | |
| | | | | | |
| | | | | | |
| | | | | | |

7 CONTRACTOR'S OR LANDOWNER'S CERTIFICATION: This water well was plugged under my jurisdiction and was completed on (mo/day/year) 8-3-16 and this record is true to the best of my knowledge and belief. Kansas Water Well Contractor's License No. 710. This Water Well Record was completed on (mo/day/year) 8-5-16 under the business name of Below Ground Surface, Inc. by (signature) [Signature]

Send one white copy to Kansas Department of Health & Environment, Geology Section, 1000 SW Jackson Street, Ste. 420, Topeka, KS 66612-1367. Send one copy to WATER WELL OWNER and retain one for your records.
 Visit us at <http://www.kdheks.gov/waterwell/index.html> Telephone 785-296-5524.



| | | | | | | | | |
|--------------------|-----------|------------|----------------------------------------------------|--|---|---------------------------------------------------------------------------------------|----------------------|------|
| 2 FIGURE | DESIGNED | DOD | Former Binney & Smith Plant Winfield, Kansas | |  Environmental Resources Management 10955 Lowell Avenue Suite 1060 Overland Park, Kansas 66210 (913) 661-0770 |  | REVISION DESCRIPTION | DATE |
| | DRAWN | DOD | Potentiometric Surface Map December 2015 | | | | | |
| | CHECKED | JEG | | | | | | |
| | DATE | 12/22/2015 | | | | | | |
| | TIME | 15:22 | | | | | | |
| | PROJECT # | 0132731 | | | | | | |