


MW-18

WATER WELL PLUGGING RECORD Form WWC-5P KSA 82a-1212 ID NO.

1 LOCATION OF WATER WELL: County: Cowley Fraction: 1/4 SW 1/4 SE 1/4 SE 1/4 Section Number: 27 Township Number: T 32 S Range Number: 4 [X] E [] W

Street/Rural Address of Well Location: 2000 Liquitek Lane Winfield KS 67156 Global Positioning Systems (GPS) information: Latitude: 37.23044 Longitude: -96.97474

2 WATER WELL OWNER: Crayola LLC (Binney & Smith) RR#: 1100 Church Lane City, State ZIP Code: Easton PA 18044-0431

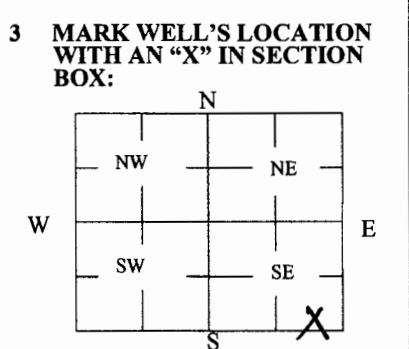

4 DEPTH OF WELL 20.5 ft. WELL'S STATIC WATER LEVEL _____ ft. WELL WAS USED AS: [] Domestic [] Irrigation [] Feedlot [] Industrial [] Public Water Supply [] Oil Field Water Supply [] Domestic (Lawn & Garden) [] Air Conditioning [X] Dewatering [] Monitoring [] Injection Well [] Other

5 TYPE OF BLANK CASING USED: [X] Steel [] RMP (SR) [] Wrought [] Fiberglass [] Other (Specify below) [X] PVC [] ABS [] Asbestos-Cement [] Concrete Tile

6 GROUT PLUG MATERIAL: [] Neat cement [] Cement grout [X] Bentonite [] Other Grout Plug Intervals: From 3 ft. to 20.5 ft., From - ft. to - ft., From - ft. to - ft.

Table with 6 columns: FROM, TO, PLUGGING MATERIALS, FROM, TO, PLUGGING MATERIALS. Row 1: 0, 3, Top soil. Row 2: 3, 20.5, Bentonite.

7 CONTRACTOR'S OR LANDOWNER'S CERTIFICATION: This water well was plugged under my jurisdiction and was completed on (mo/day/year) 8-3-16 and this record is true to the best of my knowledge and belief.

Send one white copy to Kansas Department of Health & Environment, Geology Section, 1000 SW Jackson Street, Ste. 420, Topeka, KS 66612-1367. Visit us at http://www.kdheks.gov/waterwell/index.html Telephone 785-296-5524.



2 FIGURE	DESIGNED	DGD	Former Binney & Smith Plant Winfield, Kansas Potentiometric Surface Map December 2015	Environmental Resources Management 10955 Lowell Avenue Suite 1000 Overland Park, Kansas 66210 (913) 861-0770		REVISION DESCRIPTION	DATE
	DRAWN	DGD					
	CHECKED	JEG					
	DATE	12/22/2015					
	TIME	15:22					
PROJECT #	0132731						