


MW-19

WATER WELL PLUGGING RECORD Form WWC-5P KSA 82a-1212 ID NO.

1 LOCATION OF WATER WELL: County: Cowley Fraction 1/4 SW 1/4 SE 1/4 SE 1/4 Section Number 27 Township Number T 32 S Range Number 4 E W

Street/Rural Address of Well Location: 2000 Liquitek Lane Winfield KS 67156 Global Positioning Systems (GPS) information: Latitude: 37.23045 Longitude: -96.97408

2 WATER WELL OWNER: Crayola LLC (Binney & Smith) RR#: 1100 Church Lane City, State ZIP Code: Easton PA 18044-0431

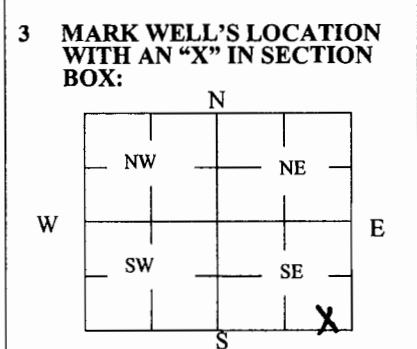

4 DEPTH OF WELL 22 ft. WELL'S STATIC WATER LEVEL _____ ft. WELL WAS USED AS: Domestic, Irrigation, Feedlot, Industrial, Public Water Supply, Oil Field Water Supply, Domestic (Lawn & Garden), Air Conditioning, Dewatering, Monitoring, Injection Well, Other.

5 TYPE OF BLANK CASING USED: Steel, RMP (SR), Wrought, Fiberglass, Other, PVC, ABS, Asbestos-Cement, Concrete Tile. Blank casing diameter 2 in. Was casing pulled? Yes No. Casing height above or below land surface -6 in.

6 GROUT PLUG MATERIAL: Neat cement, Cement grout, Bentonite, Other. Grout Plug Intervals: From 3 ft. to 22 ft., From - ft. to - ft., From - ft. to - ft. What is the nearest source of possible contamination: Septic tank, Sewer lines, Watertight sewer lines, Lateral lines, Cess pool, Seepage pit, Pit privy, Sewage lagoon, Feedyard, Livestock pens, Fuel storage, Fertilizer storage, Insecticide storage, Abandoned water well, Oil well/Gas well.

Table with columns: FROM, TO, PLUGGING MATERIALS. Rows: 0 to 3 (Top soil), 3 to 22 (Bentonite).

7 CONTRACTOR'S OR LANDOWNER'S CERTIFICATION: This water well was plugged under my jurisdiction and was completed on (mo/day/year) 8-3-16 and this record is true to the best of my knowledge and belief. Kansas Water Well Contractor's License No. 710. This Water Well Record was completed on (mo/day/year) 8-5-16 under the business name of Below Ground Surface, Inc. by (signature) [Signature]

Send one white copy to Kansas Department of Health & Environment, Geology Section, 1000 SW Jackson Street, Ste. 420, Topeka, KS 66612-1367. Send one copy to WATER WELL OWNER and retain one for your records. Visit us at http://www.kdheks.gov/waterwell/index.html Telephone 785-296-5524.



2 FIGURE	DESIGNED	DGD	Former Binney & Smith Plant Winfield, Kansas Potentiometric Surface Map December 2015	 Environmental Resources Management 10955 Lowell Avenue Suite 1000 Overland Park, Kansas 66210 (913) 861-0770		REVISION DESCRIPTION	DATE
	DRAWN	DGD					
	CHECKED	JEG					
	DATE	12/22/2015					
	PROJECT #	0132731					