



Legend


- ⊙ MWB1 - Monitoring Well Location (MW3SS, MW4SS, MW7Ss, MWB8 Plugged)
- ⊙ MW15 - Additional Monitoring Well Location
- CP1 - Continuous Probe Location
- CP1 - Additional Probe Location
- EC1 - Electric Conductivity Probe Location

--- Property Line
 --- Property Line

- OH — Overhead Power Line
- SA — Sanitary Sewer Line (~4' deep)
- FO — Fiber Optic (~3' Deep)
- W — Water Line (~4' deep)
- G — Gas Line (~3' deep)
- BT — Buried Telephone (~2' deep)
- ST — Storm Sewer (Culvert) (~1' deep)

- PP • Power Pole
- LP • Light Pole
- MH • Manhole
- Ped • Phone Pedestal
- WM • Water Meter
- FH • Fire Hydrant
- CO • Clean Out
- Tree

Scale In Feet
 0 30 60

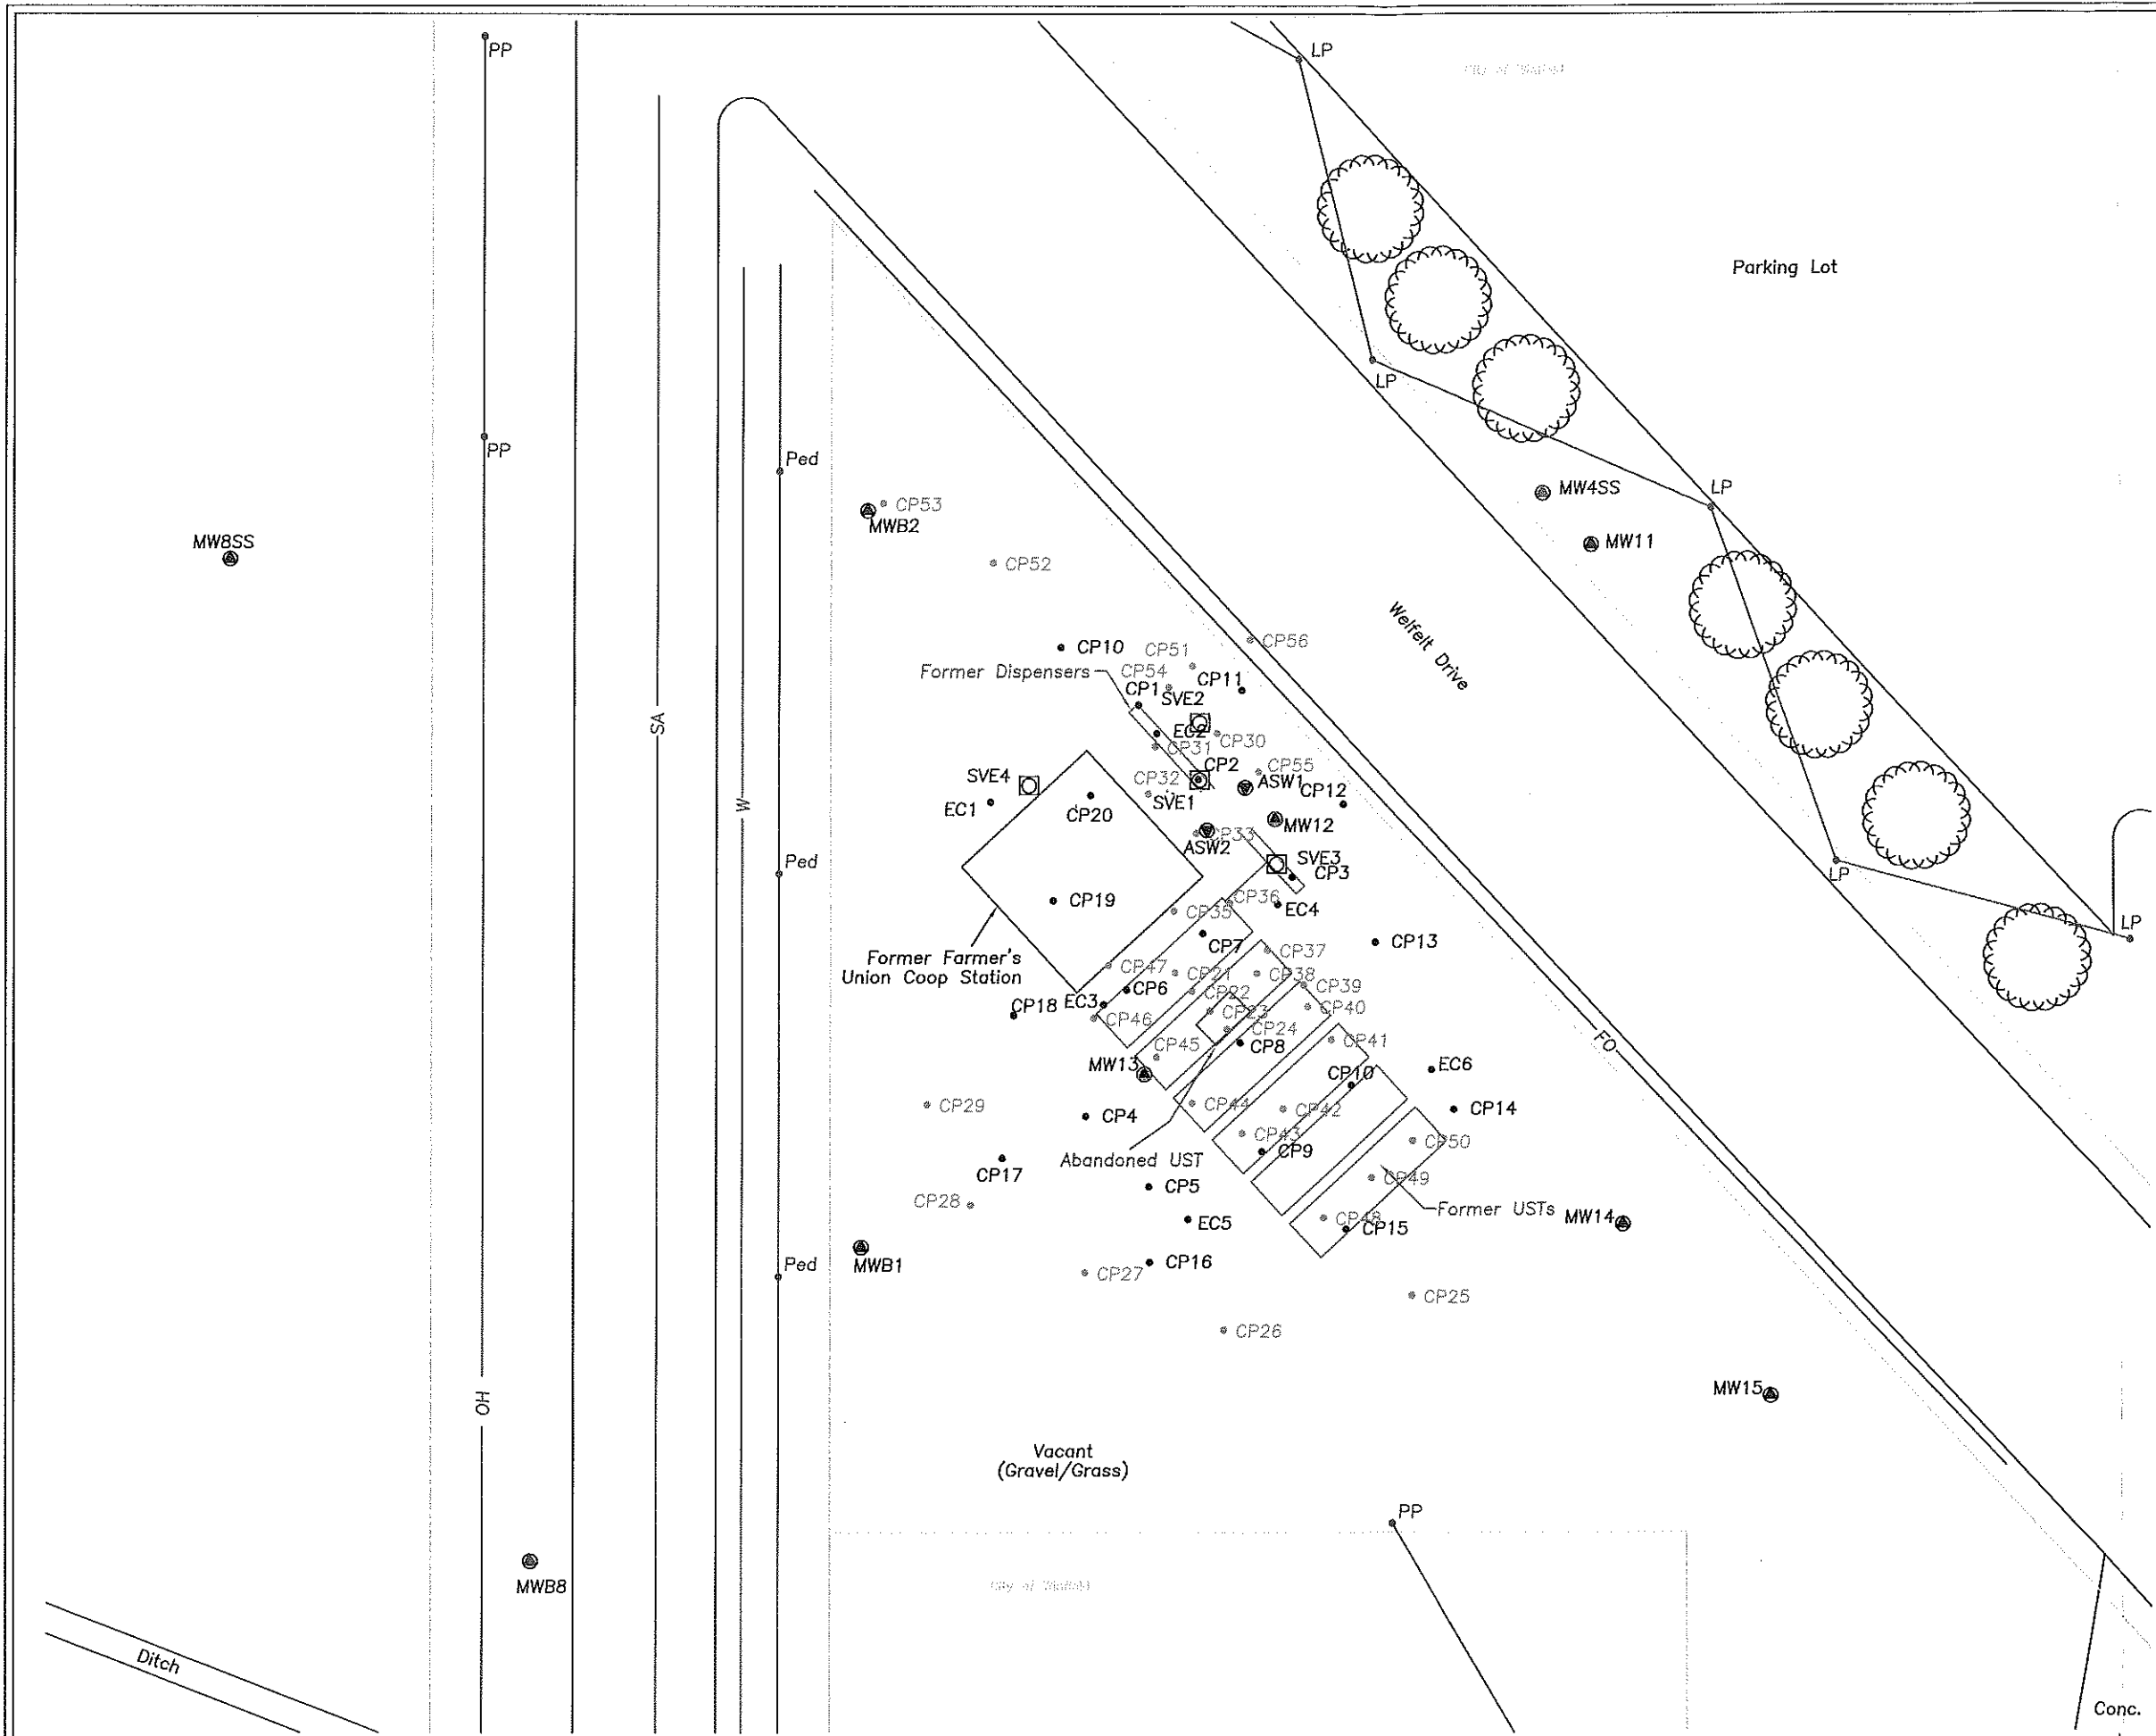

Area Map
Winfield Farmers Union Coop Winfield, KS
KDHE Project Code: U2-018-00341
RDP
CGP Project #17815K
Prepared By: LD Date: 6-19-2018
Reviewd By: MK Date: 6-19-2018
Drawing 1.7.1a
CGP, Inc. PO Box 23, Wahoo, NE 68066