

WATER WELL RECORD

Form WWC-5

Division of Water Resources App. No.


Well ID

MW1

Original Record Correction Change in Well Use

1 LOCATION OF WATER WELL: County Cowley Fraction SW 1/4 SE 1/4 SE 1/4 NW 1/4 Section Number 28 Township Number T 32 S Range Number R 4 E W

2 WELL OWNER: Last Name: Business: KDHE (Wiebe Tire) Address: 1000 SW Jackson City Topeka State: KS ZIP: 66612 Street or Rural Address where well is located (if unknown, distance and direction from nearest town or intersection): 1121 Main, Winfield, KS

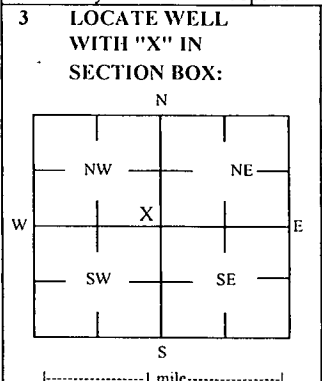

3 LOCATE WELL WITH "X" IN SECTION BOX: 4 DEPTH OF COMPLETED WELL: 23 ft Depth(s) Groundwater Encountered: 1) 23 ft 2) 3) 4) Dry Well WELL'S STATIC WATER LEVEL: 13.27 ft. below land surface, measured on (mo-day-yr) 2/14/20

5 Latitude: 37.23747 (decimal degrees) Longitude: 96.99737 (decimal degrees) Horizontal Datum: X WGS 84 Source for Latitude/Longitude: X Land Survey

6 Elevation: 1127.29 ft Ground Level: X TOC Source: X Land Survey

7 WELL WATER TO BE USED AS: 1 Domestic: 2 Irrigation 3 Feedlot 4 Industrial 5 Public Water Supply: well ID 6 Dewatering: how many wells? 7 Aquifer Recharge: well ID 8 Monitoring: well ID MW1 9 Environmental Remediation: well ID 10 Oil Field Water Supply: lease 11 Test Hole: well ID 12 Geothermal: How many bores?

Was a chemical/bacteriological sample submitted to KDHE? No Water well disinfected? No

8 TYPE OF CASING USED: PVC CASING JOINTS: Threaded Casing diameter: 2 in. to 10 ft. Diameter: 2 in. to 10 ft. Casing height above land surface: -0.28 in. Weight: lbs./ft. Well thickness or gauge No.

TYPE OF SCREEN OR PERFORMANCE MATERIAL: PVC SCREEN OR PERFORMANCE OPENINGS ARE: Mill Slot

SCREEN-PERFORATED INTERVALS: From 10 ft. to 23 ft. GRAVEL PACK INTERVALS: From 8 ft. to 23 ft.

9 GROUT MATERIAL: Bentonite Other Concrete: 0-0.5' Grout intervals: From 0.5 ft. to 8 ft.

Nearest source of possible contamination: Fuel Storage Direction from well? SW Distance from well? ~30 ft

Table with 6 columns: FROM, TO, LITHOLOGIC LOG, FROM, TO, LITHO. LOG (cont.) or PLUGGING INTERVALS. Rows show depth intervals and lithology: Concrete, Gravel, sand, Silty clay, Shaley clay, Shaley, silty clay, Silty, sandy clay, Silty sand, some clay.

11 CONTRACTOR'S OR LANDOWNER'S CERTIFICATION: This water well was constructed, jurisdiction and was completed on (mo-day-year) 2/5/20 and this record is true to the best of my knowledge and belief. License No 757 This Water Well Record was completed on (mo-day-year) 3/10/20 under the business name of Larsen & Associates, Inc. Signature

Mail 1 white copy along with a fee of \$5.00 for each constructed well to: Kansas Department of Health and Environment, Bureau of Water, 1000 SW Jackson St., Suite 420, Topeka, Kansas 66612-1367. Mail one to Water Well Owner and retain one for your records. Telephone: 785-296-5524.

Lowley 10

NE SW

20-22-4E

DENNIS L HANDKE

1820 NW 59th Terrace
TOPEKA, KANSAS 66618
785-286-4047 Home
785-286-1990 Fax

Jessica Chapman
Larsen & Associates
1311 E. 25th Street, Suite B
Lawrence, Kansas, 66046

February 29, 2020

RE: Monitor Well Elevation Survey
1121 Main St., Winfield, Kansas

Proj. 20-00J
Wiebe Tire
U2-018-01326

Bench Mark: Chisled X on top SE bolt of East leg on concrete sign base at Southeast corner of property.
Elev: 1127.58 North 2677.70 West 2973.90 (from SE Cor. Sec. 28-32-4E)


MW-1	rim	1127.57	North	2729.07	SW1/4,SE1/4,SE1/4,NW1/4
	top pipe	1127.29	West	2975.77	Lat= 37.23747 Long = 96.99737
MW-2	rim	1127.79	North	2702.33	SW1/4,SE1/4,SE1/4,NW1/4
	top pipe	1127.46	West	3056.81	Lat= 37.23739 Long = 96.99764
MW-3	rim	1127.35	North	2705.34	SW1/4,SE1/4,SE1/4,NW1/4
	top pipe	1126.89	West	3149.85	Lat= 37.23740 Long = 96.99796
MW-4	rim	1127.27	North	2556.97	NW1/4,NE1/4,NE1/4,SW1/4
	top pipe	1126.89	West	3108.49	Lat= 37.23699 Long = 96.99781
MW-5	rim	1127.41	North	2601.01	NW1/4,NE1/4,NE1/4,SW1/4
	top pipe	1126.78	West	3176.33	Lat= 37.23711 Long = 96.99805
MW-6	rim	1127.35	North	2583.61	NE1/4,NW1/4,NE1/4,SW1/4
	top pipe	1126.86	West	3334.06	Lat= 37.23706 Long = 96.99859
MW-7	rim	1126.90	North	2344.97	NW1/4,NE1/4,NE1/4,SW1/4
	top pipe	1126.46	West	2989.37	Lat= 37.23641 Long = 96.99740
MW-8	rim	1127.55	North	2424.81	NE1/4,NE1/4,NE1/4,SW1/4
	top pipe	1127.17	West	2848.58	Lat= 37.23664 Long = 96.99692


Lat & Long derived from Winfield 7.5' quad map. WGS 84.

Elevation established from NGS BM C 242 NAVD 88.

If you have any questions, please feel free to call me. Thank you for the opportunity to be of service to you.

March 1, 2020
 15-785
 Dennis L Handke RLS

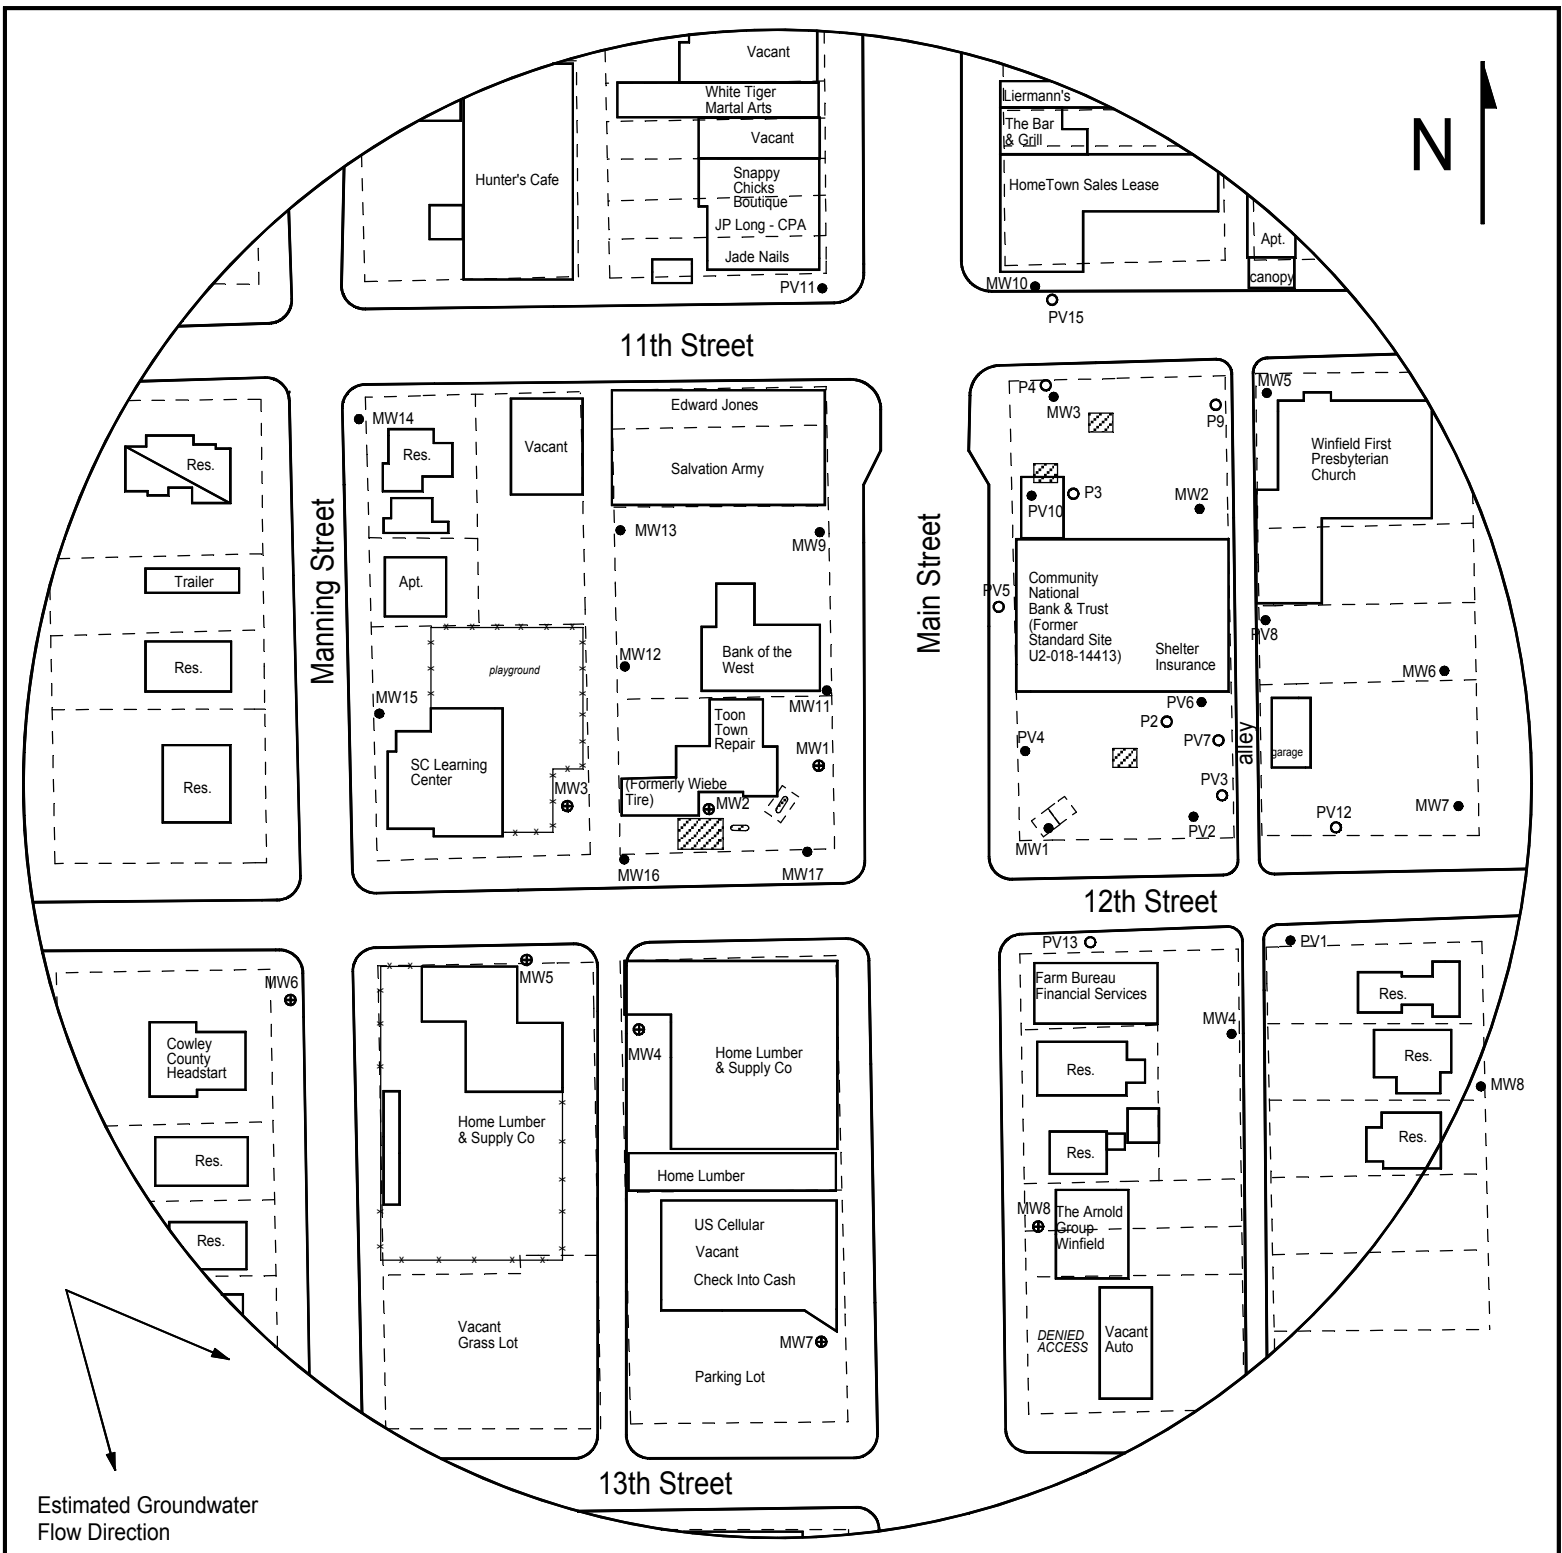


larsen
& ASSOCIATES, INC.

1311 E 25th St., Suite B
Lawrence, KS 66046







785-841-8707 office
785-865-4282 fax

PROJECT:
Wiebe Tire
1121 Main
Winfield, KS
KDHE ID: U2-018-01326
Date: 2/14/20

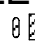

0 100 ft

LEGEND

-  Approximate Location of Former UST Basins & Pump Islands
-  Building with Basement
-  Approximate Location of Property Line
-  Existing Monitoring Well
-  Monitoring Well (Installed 2/5-7/20; 2/10/20)
-  Plugged Well