

PROJECT: CASEY'S #1822

ADDRESS: 219 W. 9TH

LOCATION: WINFIELD, KS

DRAWN BY: B. STALNAKER **DATE:** 5/3/18

REVISED BY: B. STALNAKER **DATE:** 9/25/20


AE JOB # TF514 **KDHE JOB #** U2-018-15063

TITLE:

ASSOCIATED ENVIRONMENTAL INC.

LEGEND:

- = CURRENT BASINS AND PRODUCT LINES
- = MONITORING WELL
- = MONITORING WELL (REEVES & SONS)
- = PROPOSED MONITORING WELL
- = SUBJECT PROPERTY

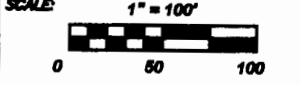

NOTES: