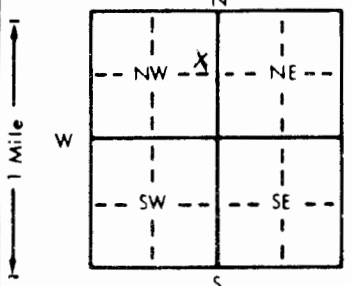


MW # 2

1 LOCATION OF WATER WELL
 County: **SEDGWICK** Fraction: **SE 1/4 NE 1/4 NW 1/4** Section Number: **33** Township Number: **T 32 S** Range Number: **R 4 E/W**

Distance and direction from nearest town or city street address of well if located within city?
2126 S. MAIN WINFIELD KS.

2 WATER WELL OWNER: **TOWN & COUNTRY MARKET**
 RR#, St. Address, Box # : **P.O. BOX 17087** Board of Agriculture, Division of Water Resources
 City, State, ZIP Code : **WICHITA KS. 67217** Application Number:

3 LOCATE WELL'S LOCATION WITH AN "X" IN SECTION BOX:

 4 DEPTH OF COMPLETED WELL: **19** ft. ELEVATION:
 Depth(s) Groundwater Encountered: **1, 1.4** ft. 2. ft. 3. ft.
 WELL'S STATIC WATER LEVEL: **14** ft. below land surface measured on mo/day/yr
 Pump test data: Well water was ft. after hours pumping gpm
 Est. Yield gpm: Well water was ft. after hours pumping gpm
 Bore Hole Diameter: **7 1/4** in. to ft., and in. to ft.
 WELL WATER TO BE USED AS:
 1 Domestic 3 Feedlot 6 Oil field water supply 9 Dewatering 12 Other (Specify below)
 2 Irrigation 4 Industrial 7 Lawn and garden only 10 Monitoring well
 Was a chemical/bacteriological sample submitted to Department? Yes No ; If yes, mo/day/yr sample was submitted
 Water Well Disinfected? Yes No

5 TYPE OF BLANK CASING USED:
 1 Steel 3 RMP (SR) 5 Wrought iron 8 Concrete tile CASING JOINTS: Glued Clamped
 2 PVC 4 ABS 7 Fiberglass Welded
 Blank casing diameter: **2** in. to **9** ft., Dia. in. to ft., Dia. in. to ft.
 Casing height above land surface: **-0.5** in., weight: **sched 40** lbs./ft. Wall thickness or gauge No.
 TYPE OF SCREEN OR PERFORATION MATERIAL:
 1 Steel 3 Stainless steel 5 Fiberglass 8 RMP (SR) 10 Asbestos-cement
 2 Brass 4 Galvanized steel 6 Concrete tile 9 ABS 12 None used (open hole)
 SCREEN OR PERFORATION OPENINGS ARE:
 1 Continuous slot 2 Mill slot 5 Gauzed wrapped 8 Saw cut 11 None (open hole)
 2 Louvered shutter 4 Key punched 6 Wire wrapped 9 Drilled holes
 SCREEN-PERFORATED INTERVALS: From: **19** ft. to **9** ft., From ft. to ft.
 From ft. to ft., From ft. to ft.
 GRAVEL PACK INTERVALS: From: **19** ft. to **8** ft., From ft. to ft.
 From ft. to ft., From ft. to ft.

6 GROUT MATERIAL: 1 Neat cement 2 Cement grout 3 Bentonite 4 Other
 Grout intervals: From: **7** ft. to **0.5** ft., From ft. to ft., From ft. to ft.
 What is the nearest source of possible contamination:
 1 Septic tank 4 Lateral lines 7 Pit privy 10 Livestock pens 14 Abandoned water well
 2 Sewer lines 5 Cess pool 8 Sewage lagoon 12 Fertilizer storage 15 Oil well/Gas well
 3 Watertight sewer lines 6 Seepage pit 9 Feedyard 13 Insecticide storage 16 Other (specify below)
 Direction from well? **N/E** How many feet? **16'**

FROM	TO	LITHOLOGIC LOG	FROM	TO	PLUGGING INTERVALS
0	0,8	concrete			
0,8	5.0	topsoil and drk brn clay			
5.0	10	brn clay			
10	15'	brn to tan clay at 13'			
15	16	sandy brn clay saturated @ 14.0'			
16	19'	brn sandy clay to 18' limestone @ 18'			

7 CONTRACTOR'S OR LANDOWNER'S CERTIFICATION: This water well was (1) constructed, (2) reconstructed, or (3) plugged under my jurisdiction and was completed on (mo/day/year) **11-7-94** and this record is true to the best of my knowledge and belief. Kansas Water Well Contractor's License No. **575**. This Water Well Record was completed on (mo/day/yr) **11-22-94** under the business name of **KURTZ ENVIRONMENTAL SERVICE** by (signature) *[Signature]*

INSTRUCTIONS: Use typewriter or ball point pen. PLEASE PRESS FIRMLY and PRINT clearly. Please fill in blanks, underline or circle the correct answers. Send top three copies to Kansas Department of Health and Environment, Bureau of Water, Topeka, Kansas 66620-0001. Telephone: 913-296-5545. Send one to WATER WELL OWNER and retain one for your records.

OFFICE USE ONLY
T
R
E/W
SEC
1/4
1/4
1/4