


MW# 2

1 LOCATION OF WATER WELL: Fraction SE 1/4 NE 1/4 NW 1/4 Section Number 33 Township Number T 32 S Range Number R 4 EW  
 County: ~~SEDWICK~~ **Cowley**  
 Distance and direction from nearest town or city street address of well if located within city?  
**2126 S MAIN WINFIELD KS.**

2 WATER WELL OWNER: **TOWN & COUNTRY MARKET**  
 RR#, St. Address, Box #: **P.O. BOX 17087** Board of Agriculture, Division of Water Resources  
 City, State, ZIP Code: **WICHITA KS 67217** Application Number:

3 LOCATE WELL'S LOCATION WITH AN "X" IN SECTION BOX:

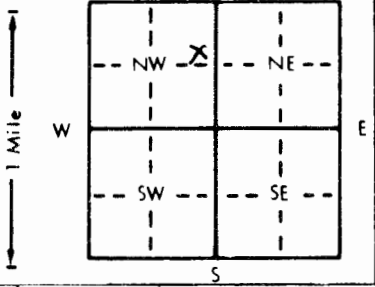

4 DEPTH OF COMPLETED WELL: **17.5** ft. ELEVATION:  
 Depth(s) Groundwater Encountered 1. **14** ft. 2. ft. 3. ft.  
 WELL'S STATIC WATER LEVEL **14** ft. below land surface measured on mo/day/yr  
 Pump test data: Well water was ft. after hours pumping gpm  
 Est. Yield gpm: Well water was ft. after hours pumping gpm  
 Bore Hole Diameter: **7.1/4** in. to **1.7.5** ft., and in. to ft.  
 WELL WATER TO BE USED AS:  
 5 Public water supply 8 Air conditioning 11 Injection well  
 1 Domestic 3 Feedlot 6 Oil field water supply 9 Dewatering 12 Other (Specify below)  
 2 Irrigation 4 Industrial 7 Lawn and garden only **10** Monitoring well  
 Was a chemical/bacteriological sample submitted to Department? Yes.....No **X**..... If yes, mo/day/yr sample was submitted  
 Water Well Disinfected? Yes No

5 TYPE OF BLANK CASING USED:  
 1 Steel 3 RMP (SR) 5 Wrought iron 8 Concrete tile CASING JOINTS: Glued.....Clamped.....  
**X** PVC 4 ABS 6 Asbestos-Cement 9 Other (specify below) Welded.....  
 7 Fiberglass Threaded.....

Blank casing diameter **2** in. to **7.5** ft. Dia. in. to ft. Dia. in. to ft.  
 Casing height above land surface **-0.5** in., weight **sched 40** lbs./ft. Wall thickness or gauge No.

TYPE OF SCREEN OR PERFORATION MATERIAL:  
 1 Steel 3 Stainless steel 5 Fiberglass **X** PVC 10 Asbestos-cement  
 2 Brass 4 Galvanized steel 6 Concrete tile 8 RMP (SR) 11 Other (specify).....  
 12 None used (open hole)

SCREEN OR PERFORATION OPENINGS ARE:  
 1 Continuous slot **3** Mill slot 5 Gauzed wrapped 8 Saw cut 11 None (open hole)  
 2 Louvered shutter 4 Key punched 6 Wire wrapped 9 Drilled holes  
 7 Torch cut 10 Other (specify).....

SCREEN-PERFORATED INTERVALS: From **17.5** ft. to **7.5** ft., From ft. to ft.  
 From ft. to ft., From ft. to ft.  
 GRAVEL PACK INTERVALS: From **17.5** ft. to **6.0'** ft., From ft. to ft.  
 From ft. to ft., From ft. to ft.

6 GROUT MATERIAL: 1 Neat cement **X** Cement grout 3 Bentonite 4 Other.....  
 Grout Intervals: From **5.0** ft. to **-0.5** ft., From ft. to ft., From ft. to ft.

What is the nearest source of possible contamination:  
 1 Septic tank 4 Lateral lines 7 Pit privy 10 Livestock pens 14 Abandoned water well  
 2 Sewer lines 5 Cess pool 8 Sewage lagoon **X** 1 Fuel storage 15 Oil well/Gas well  
 3 Watertight sewer lines 6 Seepage pit 9 Feedyard 12 Fertilizer storage 16 Other (specify below)  
 13 Insecticide storage  
 Direction from well? **east** How many feet? **16'**

FROM	TO	LITHOLOGIC LOG	FROM	TO	PLUGGING INTERVALS
0	0.5	concrete			
0.5	5'	topsoil			
5'	10'	drk brn clay			
10'	15'	drk brn clay with coleche			
15.0	17.5	sandy olive green clay saturated @ 14.0' limestone @ 17.0'			

7 CONTRACTOR'S OR LANDOWNER'S CERTIFICATION: This water well was (1) constructed, (2) reconstructed, or (3) plugged under my jurisdiction and was completed on (mo/day/year) **11-7-94** and this record is true to the best of my knowledge and belief. Kansas Water Well Contractor's License No. **575** This Water Well Record was completed on (mo/day/yr) **11-22-94** under the business name of **KURTZ ENVIRONMENTAL SERVICE** by (signature) *[Signature]*

OFFICE USE ONLY  
T  
R  
EW  
SEC.  
1/4  
1/4  
1/4