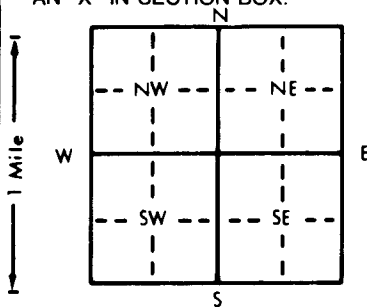


1 LOCATION OF WATER WELL: Fraction SW 1/4 NE 1/4 NE 1/4 Section Number 28 Township Number T 32 S Range Number R 4 **EW**
 County: Cowley

Distance and direction from nearest town or city street address of well if located within city?
 519 E 9th Boring No. 8, MW-7

2 WATER WELL OWNER: Super Quick
 RR#, St. Address, Box #: 519 E 9th Board of Agriculture, Division of Water Resources
 City, State, ZIP Code: Winfield, Ks Application Number:

3 LOCATE WELL'S LOCATION WITH AN "X" IN SECTION BOX: 
 4 DEPTH OF COMPLETED WELL: 22.5 ft. ELEVATION:
 Depth(s) Groundwater Encountered 1. 17.5 ft. 2. ft. 3. ft.
 WELL'S STATIC WATER LEVEL: 17.5 ft. below land surface measured on mo/day/yr 1-12-91
 Pump test data: Well water was ft. after hours pumping gpm
 Est. Yield gpm: Well water was ft. after hours pumping gpm
 Bore Hole Diameter: 7.5/8 in. to 22.5 ft., and in. to ft.
 WELL WATER TO BE USED AS:
 5 Public water supply 8 Air conditioning 11 Injection well
 1 Domestic 3 Feedlot 6 Oil field water supply 9 Dewatering 12 Other (Specify below)
 2 Irrigation 4 Industrial 7 Lawn and garden only 10 Monitoring well
 Was a chemical/bacteriological sample submitted to Department? Yes No; If yes, mo/day/yr sample was submitted
 Water Well Disinfected? Yes No

5 TYPE OF BLANK CASING USED:
 1 Steel 3 RMP (SR) 5 Wrought iron 8 Concrete tile CASING JOINTS: Glued Clamped
 2 PVC 4 ABS 6 Asbestos-Cement 9 Other (specify below) Welded
 7 Fiberglass Threaded
 Blank casing diameter 2 in. to 12.5 ft. Dia. in. to ft. Dia. in. to ft.
 Casing height above land surface 0 in., weight lbs./ft. Wall thickness or gauge No. Sch. 40
 TYPE OF SCREEN OR PERFORATION MATERIAL:
 1 Steel 3 Stainless steel 5 Fiberglass 7 PVC 10 Asbestos-cement
 2 Brass 4 Galvanized steel 6 Concrete tile 8 RMP (SR) 11 Other (specify)
 9 ABS 12 None used (open hole)
 SCREEN OR PERFORATION OPENINGS ARE:
 1 Continuous slot 3 Mill slot 5 Gauzed wrapped 8 Saw cut 11 None (open hole)
 2 Louvered shutter 4 Key punched 6 Wire wrapped 9 Drilled holes
 7 Torch cut 10 Other (specify)
 SCREEN-PERFORATED INTERVALS: From 22.5 ft. to 12.5 ft. From ft. to ft.
 GRAVEL PACK INTERVALS: From 22.5 ft. to 10.5 ft. From ft. to ft.

6 GROUT MATERIAL: 1 Neat cement 2 Cement grout 3 Bentonite 4 Other
 Grout Intervals: From 10.5 ft. to 0 ft. From ft. to ft. From ft. to ft.
 What is the nearest source of possible contamination:
 1 Septic tank 4 Lateral lines 7 Pit privy 10 Livestock pens 14 Abandoned water well
 2 Sewer lines 5 Cess pool 8 Sewage lagoon 11 Fuel storage 15 Oil well/Gas well
 3 Watertight sewer lines 6 Seepage pit 9 Feedyard 12 Fertilizer storage 16 Other (specify below)
 13 Insecticide storage Fuel storage tanks
 Direction from well? How many feet?

FROM	TO	LITHOLOGIC LOG	FROM	TO	PLUGGING INTERVALS
0	7	Clay-silty, brown & Dk. gray brown			
7	12	Clay-silty, yellowish brown & brown			
12	14	Clay-silty, yellowish brown			Completed at surface with water tight locking cap and bolt down steel manhole cover.
14	15.5	Clay-sandy, yellow brown			
15.5	18.5	Sand-silty, yellow gray & gray brown, wet			
18.5	21.5	Sand-gravelly, lt. brown, well sorted, VF to coarse			
21.5	22.5	Limestone-fractured			
22.5		TD			

7 CONTRACTOR'S OR LANDOWNER'S CERTIFICATION: This water well was (1) constructed, (2) reconstructed, or (3) plugged under my jurisdiction and was completed on (mo/day/year) 1-12-91 and this record is true to the best of my knowledge and belief. Kansas Water Well Contractor's License No. 527 This Water Well Record was completed on (mo/day/yr) 2-28-91 under the business name of GeoCore Services, Inc. by (signature) Dalabell

OFFICE USE ONLY
T
R
EW
SEC.