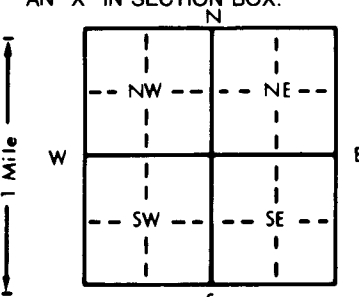


1 LOCATION OF WATER WELL: Fraction SW 1/4 NE 1/4 NE 1/4 Section Number 28 Township Number T 32 S Range Number R 4 **EW**

Distance and direction from nearest town or city street address of well if located within city?
 519 E 9th Boring # 1 MW-1

2 WATER WELL OWNER: Super Quick
 RR#, St. Address, Box # : 519 E 9th Board of Agriculture, Division of Water Resources
 City, State, ZIP Code : Winfield, Ks Application Number:

3 LOCATE WELL'S LOCATION WITH AN "X" IN SECTION BOX:


4 DEPTH OF COMPLETED WELL... 21... ft. ELEVATION: ...
 Depth(s) Groundwater Encountered 1... 16.5... ft. 2... ft. 3... ft.
 WELL'S STATIC WATER LEVEL... 16.5... ft. below land surface measured on mo/day/yr .1-11-91...
 Pump test data: Well water was ... ft. after ... hours pumping ... gpm
 Est. Yield ... gpm: Well water was ... ft. after ... hours pumping ... gpm
 Bore Hole Diameter .75/8 in. to .21... ft., and ... in. to ... ft.
 WELL WATER TO BE USED AS: 5 Public water supply 8 Air conditioning 11 Injection well
 1 Domestic 3 Feedlot 6 Oil field water supply 9 Dewatering 12 Other (Specify below)
 2 Irrigation 4 Industrial 7 Lawn and garden only **10 Monitoring well**
 Was a chemical/bacteriological sample submitted to Department? Yes... No...; If yes, mo/day/yr sample was submitted
 Water Well Disinfected? Yes No

5 TYPE OF BLANK CASING USED:
 1 Steel 3 RMP (SR) 5 Wrought iron 8 Concrete tile CASING JOINTS: Glued... Clamped...
2 PVC 4 ABS 6 Asbestos-Cement 9 Other (specify below) Welded...
 7 Fiberglass Threaded...
 Blank casing diameter ... 2... in. to ... 1.1... ft., Dia ... in. to ... ft., Dia ... in. to ... ft.
 Casing height above land surface ... 0... in., weight ... lbs./ft. Wall thickness or gauge No. S.ch. 4.0
 TYPE OF SCREEN OR PERFORATION MATERIAL:
 1 Steel 3 Stainless steel 5 Fiberglass 8 RMP (SR) 10 Asbestos-cement
 2 Brass 4 Galvanized steel 6 Concrete tile 9 ABS 11 Other (specify) ...
 12 None used (open hole)
 SCREEN OR PERFORATION OPENINGS ARE:
 1 Continuous slot **3 Mill slot** 5 Gauzed wrapped 8 Saw cut 11 None (open hole)
 2 Louvered shutter 4 Key punched 6 Wire wrapped 9 Drilled holes
 7 Torch cut 10 Other (specify) ...
 SCREEN-PERFORATED INTERVALS: From ... 2.1... ft. to ... 1.1... ft., From ... ft. to ... ft.
 GRAVEL PACK INTERVALS: From ... 2.1... ft. to ... 9... ft., From ... ft. to ... ft.

6 GROUT MATERIAL: 1 Neat cement 2 Cement grout **3 Bentonite** 4 Other
 Grout Intervals: From ... 9... ft. to ... 0... ft., From ... ft. to ... ft., From ... ft. to ... ft.
 What is the nearest source of possible contamination:
 1 Septic tank 4 Lateral lines 7 Pit privy 10 Livestock pens 14 Abandoned water well
 2 Sewer lines 5 Cess pool 8 Sewage lagoon 11 Fuel storage 15 Oil well/Gas well
 3 Watertight sewer lines 6 Seepage pit 9 Feedyard 12 Fertilizer storage **16 Other (specify below)**
 13 Insecticide storage Fuel Storage tanks
 Direction from well? How many feet?

FROM	TO	LITHOLOGIC LOG	FROM	TO	PLUGGING INTERVALS
0	.5	Fill - crushed rock			
.5	7	Clay-silty, dk. gray brown, 5% VF sand, wet			Completed at surface with water tight locking cap and bolt down steel manhole cover
7	11	Clay-silty, gray brown, yellow brown, 3% F sand, wet			
11	14.5	Clay-silty, brown, yellow brown, 10% VF sand, wet			
14.5	15	Clay-sandy, brown			
15	18	Sand-silty, brown, yellow brown fine, saturated at 16.5'			
18	20	Sand-gravelly, Lt. brown, VF to coarse			
20	21	Clay-gravelly, Lt. yellow brown F. sand			
21		T.D.			

7 CONTRACTOR'S OR LANDOWNER'S CERTIFICATION: This water well was (1) constructed, (2) reconstructed, or (3) plugged under my jurisdiction and was completed on (mo/day/year) ... 1-12-91... and this record is true to the best of my knowledge and belief. Kansas Water Well Contractor's License No. ... 527... This Water Well Record was completed on (mo/day/yr) ... 2-28-91... under the business name of **GeoCore Services, Inc.** by (signature) *Dale A. Holt*

OFFICE USE ONLY
T
R
EW
SEC.
1/4
1/4
1/4