


USE TYPEWRITER OR BALL POINT PEN-PRESS FIRMLY. PRINT CLEARLY.

WATER WELL RECORD
KSA 82a-1201-1215

T R EW sec 1/4 1/4 1/4 No.

Kansas State Dept. Of Health
(Water Well Contractors)
Forbes-Bldg. 740
Topeka, Kansas 66620

1 Location of well:	County Cowley	Township name Vernon	Fraction MHC? NW NW NW	Section number 29	Town number 32	Range number 4 E
Distance and direction from nearest town or city: West Side Addition to Winfield, Kansas			3 Owner of well: Raymond Andes			
Street address of well, location if in city: 808 Broad St, Lot 6, Block 18			Address: Winfield, Kans.			

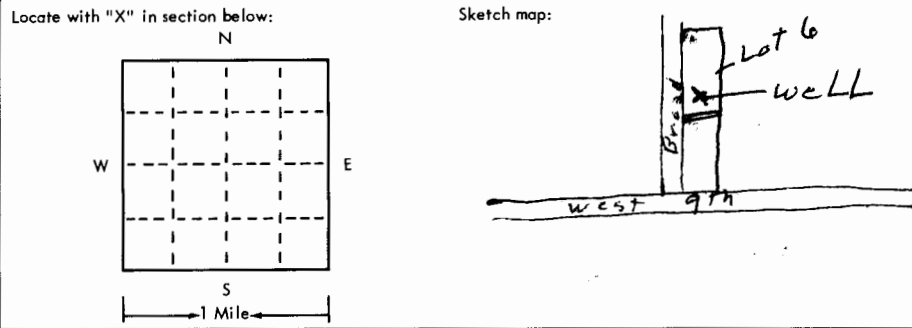

4 Well depth: **80** ft. Date of completion **12-22-76**
Well diameter **10** in.

5 Cable tool Rotary Driven Dug
 Hollow rod Jetted Bored Reverse rotary

6 Use: Domestic Public supply Industry
 Irrigation Air conditioning Commercial
 Test well **Lawn water**

7 Casing: Material **Plastic** Height: above/below
Threaded Welded Surface **12** in.
Diam. _____ Weight **#200** lbs./ft. _____
6 in. to **80** ft. depth Drive shoe? Yes No
_____ in. to _____ ft. depth

2	Type and color of material	From	To
	top soil	0	5
	Red Clay	5	10
	lime	10	30
	Blue Shale	30	80
	water vein at 60 Ft.		
	Existing 6" hole, reamed & deepened 30 Ft, to 10" hole		
(use a second sheet if needed)			

8 Screen: **Casing Perforated**
Manufacturer _____ **Bottom 10 Ft.**
Type _____ Dia. **6" MHC**
Slot/gauze _____ Length _____
Set between **10** ft. and **80** ft. _____
Fittings: _____
Gravel pack Yes No Size range of material **5/8"**

9 Static water level:
51 ft. below land surface Date **12-22-76**

10 Pumping level below land surfaces: **Boiler test**
_____ ft. after _____ hrs. pumping _____ g.p.m.
_____ ft. after _____ hrs. pumping _____ g.p.m.
Estimated maximum yield **10** g.p.m.

11 Water sample submitted:
 Yes No Date _____

12 Well head completion:
 Pitless adapter **1 Foot** inches above grade

13 Well grouted? Yes No
 Neat cement Bentonite _____
Depth: From **10** ft. to **0** ft.

14 Nearest source of possible contamination:
ft. **200** Direction **west** Type **Sewer**
Well disinfected upon completion? Yes No

15 Pump: Not installed
Manufacturer's name _____
Model number _____ HP _____ Volts _____
Length of drop pipe _____ ft. capacity _____ g.p.m.
Type:
 Submersible Turbine
 Jet Reciprocating
 Centrifugal Other

16 Remarks: elevation
172 Ft north of West Ninth Street on Broad St, (40 Ft East of Broad Street)

Topography:
 Hill
 Slope
 Upland
 Valley

17 Water well contractor's certification:
This well was drilled under my jurisdiction and this report is true to the best of my knowledge and belief.
Ronald Heffron Drilling #113
Business name _____ License No. _____
Address **Route 3, Winfield, Kansas**
Signed **Ronald Heffron** Date **12-27-76**
Authorized representative

32 4E 29 NW NW NW