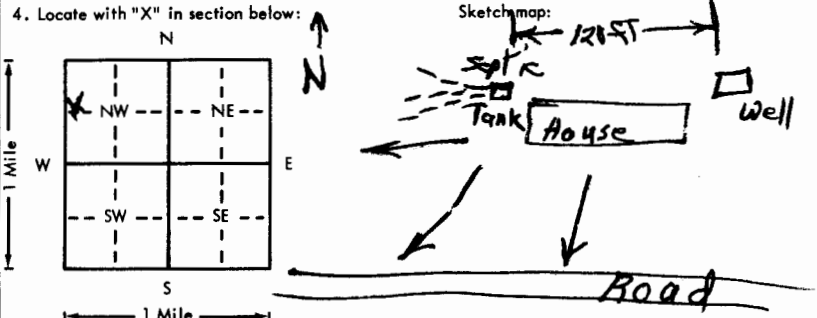


USE TYPEWRITER OR BALL POINT PEN-PRESS FIRMLY, PRINT CLEARLY.

WATER WELL RECORD
KSA 82a-1201-1215

Kansas Department of Health and Environment-Division of Environment (Water well Contractors) Topeka, Kansas 66620

1. Location of well: County Cowley		Fraction SW 1/4 NW 1/4 NW 1/4	Section number 36	Township number T 32 S R 4E E/W	Range number 4E																														
2. Distance and direction from nearest town or city: 2 1/4 miles SE of Winfield, Kans			3. Owner of well: Jean GANN R.R. or street: R. R. 5 City, state, zip code: Winfield, Kansas 67156																																
4. Locate with "X" in section below: 			6. Bore hole dia. 10 in. Completion date 5-15-76 Well depth 120 ft.																																
5. Type and color of material			7. <input checked="" type="checkbox"/> Cable tool <input type="checkbox"/> Rotary <input type="checkbox"/> Driven <input type="checkbox"/> Dug <input type="checkbox"/> Hollow rod <input type="checkbox"/> Jetted <input type="checkbox"/> Bored <input type="checkbox"/> Reverse rotary																																
<table border="1" style="width:100%; border-collapse: collapse;"> <thead> <tr> <th></th> <th>From</th> <th>To</th> </tr> </thead> <tbody> <tr> <td>Top soil & clay</td> <td>0</td> <td>17</td> </tr> <tr> <td>Blue shale</td> <td>18</td> <td>25</td> </tr> <tr> <td>Cream colored limestone</td> <td>25</td> <td>29</td> </tr> <tr> <td>Soft limestone</td> <td>29</td> <td>33</td> </tr> <tr> <td>Gray shale</td> <td>33</td> <td>69</td> </tr> <tr> <td>Hard gray shale</td> <td>69</td> <td>74</td> </tr> <tr> <td>Gray shale</td> <td>74</td> <td>98</td> </tr> <tr> <td>Hard limestone</td> <td>98</td> <td>110</td> </tr> <tr> <td>Sandy limestone</td> <td>110</td> <td>120</td> </tr> </tbody> </table>				From	To	Top soil & clay	0	17	Blue shale	18	25	Cream colored limestone	25	29	Soft limestone	29	33	Gray shale	33	69	Hard gray shale	69	74	Gray shale	74	98	Hard limestone	98	110	Sandy limestone	110	120	8. Use: <input checked="" type="checkbox"/> Domestic <input type="checkbox"/> Public supply <input type="checkbox"/> Industry <input type="checkbox"/> Irrigation <input type="checkbox"/> Air conditioning <input type="checkbox"/> Stock <input type="checkbox"/> Lawn <input type="checkbox"/> Oil field water <input type="checkbox"/> Other		
	From	To																																	
Top soil & clay	0	17																																	
Blue shale	18	25																																	
Cream colored limestone	25	29																																	
Soft limestone	29	33																																	
Gray shale	33	69																																	
Hard gray shale	69	74																																	
Gray shale	74	98																																	
Hard limestone	98	110																																	
Sandy limestone	110	120																																	
			9. Casing: Material RMP Height: Above or below Threaded <input type="checkbox"/> Welded <input type="checkbox"/> Surface 1 1/4 in. RMP <input checked="" type="checkbox"/> PVC <input type="checkbox"/> Weight 144 lbs./ft. Dia. 6 in. to 8 ft. depth Wall Thickness: inches or Dia. <input type="checkbox"/> in. to <input type="checkbox"/> ft. depth gage No. 1/4"																																
			10. Screen: Manufacturer's name Sunflower Type RMP Dia. 6" Slot/gauze 1/8" Length 30' Set between 90 ft. and 120 ft. ft. and <input type="checkbox"/> ft. Gravel pack? <input checked="" type="checkbox"/> Yes Size range of material 5/8"																																
			11. Static water level: <input type="checkbox"/> mo./day/yr. 56 ft. below land surface Date 5-5-76																																
			12. Pumping level below land surfaces: 56 ft. after <input type="checkbox"/> hrs. pumping <input type="checkbox"/> g.p.m. <input type="checkbox"/> ft. after <input type="checkbox"/> hrs. pumping <input type="checkbox"/> g.p.m. Estimated maximum yield 10 g.p.m.																																
			13. Water sample submitted: <input type="checkbox"/> mo./day/yr. Yes <input checked="" type="checkbox"/> No Date <input type="checkbox"/>																																
			14. Well head completion: <input checked="" type="checkbox"/> Pitless adapter 14 inches above grade																																
			15. Well grouted? <input checked="" type="checkbox"/> Yes With: <input type="checkbox"/> Neat cement <input type="checkbox"/> Bentonite <input checked="" type="checkbox"/> Concrete Depth: From 0 ft. to 14 ft.																																
			16. Nearest source of possible contamination: ft. 110 Direction West Type Septic Tank Well disinfected upon completion? <input checked="" type="checkbox"/> Yes <input type="checkbox"/> No																																
			17. Pump: <input type="checkbox"/> Not installed Manufacturer's name Myers Model number 52631-3A HP 1/3 Volts 115 Length of drop pipe 115 ft. capacity 11 g.p.m. Type: <input checked="" type="checkbox"/> Submersible <input type="checkbox"/> Turbine <input type="checkbox"/> Jet <input type="checkbox"/> Reciprocating <input type="checkbox"/> Centrifugal <input type="checkbox"/> Other																																
			20. Water well contractor's certification: This well was drilled under my jurisdiction and this report is true to the best of my knowledge and belief. EASTMAN Drilling 299 Business name P.O. Box 115, Winfield License No. <input type="checkbox"/> Address 6-7-76 Signed Dale Eastman Date 6-7-76 Authorized representative																																
18. Elevation:		19. Remarks:																																	
Topography: <input checked="" type="checkbox"/> Hill <input checked="" type="checkbox"/> Slope <input checked="" type="checkbox"/> Upland <input type="checkbox"/> Valley																																			

T 32 S R 4E
 Sec 36
 SW 1/4 NW 1/4

Forward the white, blue and pink copies to the Department of Health and Environment

Form WWC-5