USE TYPEWRITER OR BALL POINT PEN-PRESS FIRMLY, PRINT CLEARLY.

WATER WELL RECORD
KSA 82a-1201-1215

Kansas Department of Health and Environment-Division of Environment
(Water well Contractors)
Topeka, Kansas 66620

1. Location of well:	County: Cowley	Fraction: NW 1/4 NW 1/4 NW 1/4	Section number: 26	Township number: T 32 S	Range number: R 5 (E) W

2. Distance and direction from nearest town or city: 6 E. Winfield Ks.
Street address of well location if in city:

3. Owner of well: Dean Bailey
R.R. or street: 1719 Loomas
City, state, zip code: Winfield, Kansas 67156

4. Locate with "X" in section below:

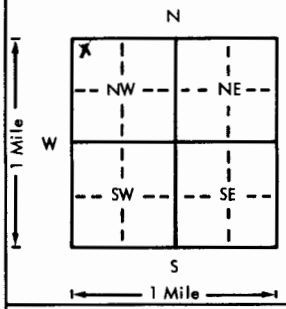

Sketch map:

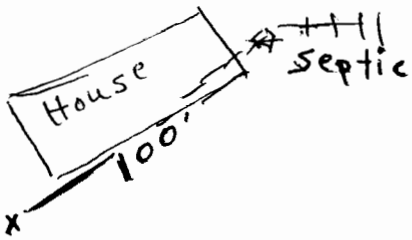

6. Bore hole dia. 8 in. Completion date 9
Well depth 110 ft. 9-25-77

7. X Cable tool __ Rotary __ Driven __ Dug
__ Hollow rod __ Jetted __ Bored __ Reverse rotary

8. Use: X Domestic __ Public supply __ Industry
__ Irrigation __ Air conditioning __ Stock
__ Lawn __ Oil field water __ Other

9. Casing: Material _____ Height: Above or below
Threaded ____ Welded ____ Surface 26 in.
RMP ____ PVC X Weight ____ lbs./ft.
Dia. 8 in. to 26 ft. depth Wall Thickness: inches or
Dia. ____ in. to ____ ft. depth gage No. 300

10. X Screen: Manufacturer's name Wimp
Type Slot Dia. 8 in.
Slot/gauze .10" Length X 6'
Set between X 20 ft. and X 26 ft.
____ ft. and ____ ft.
Gravel pack? Yes Size range of material 1/4-1/2

11. Static water level:
15 ft. below land surface Date 9-25-77 mo./day/yr.

12. Pumping level below land surfaces:
____ ft. after ____ hrs. pumping ____ g.p.m.
____ ft. after ____ hrs. pumping ____ g.p.m.
Estimated maximum yield 6 g.p.m.

13. Water sample submitted: mo./day/yr.
__ Yes X No Date

14. Well head completion:
X Pitless adapter 26 Inches above grade

15. Well grouted? ____
With: ____ Neat cement ____ Bentonite X Concrete
Depth: From 3 ft. to 15 ft.

16. Nearest source of possible contamination:
ft. 100 Direction NE Type Septic
Well disinfected upon completion? X Yes ____ No

17. Pump: X Not installed
Manufacturer's name
Model number ____ HP ____ Volts ____
Length of drop pipe ____ ft. capacity ____ g.p.m.
Type:
__ Submersible __ Turbine
__ Jet __ Reciprocating
__ Centrifugal __ Other

5. Type and color of material	From	To
Fill dirt	0	1
Soil	1	4
~~Sub soil and brown clay~~	~~4~~	~~12~~
Shale, green - grey	12	16
Limestone buff,	16	18
Shale grey	18	22
Lime, grey shaley	22	90
~~Lime grey flinty~~	~~90~~	~~108~~
Shale grey	108	
T.D.110		

(Use a second sheet if needed)

18. Elevation:

Topography:
__ Hill
X Slope
__ Upland
__ Valley

19. Remarks: Hole was reamed to 10" to 26 ft. and casing set. Caing was slotted from 20' depth to 26'. Gravel packed from 15 ft. to 26 ft. Well was cemented to 15 ft. depth. to 3 ft. of ground level. When house construction is far enough along and water lines are in I am to install the water system. At that time the well will be cemented above pitless adapter and curb will be run.

20. Water well contractor's certification:
This well was drilled under my jurisdiction and this report is true to the best of my knowledge and belief.
Bailey Drilling Co. 209
Business name License No.
Address Box 192 Burden, Kans. 67019
Signed Donald E. Bailey Date 10-8-77
Authorized representative

T 32 R 5 (E) W Sec 26 1/4 NW NW

Form WWC-5

Forward the white, blue and pink copies to the Department of Health and Environment

MI-1023