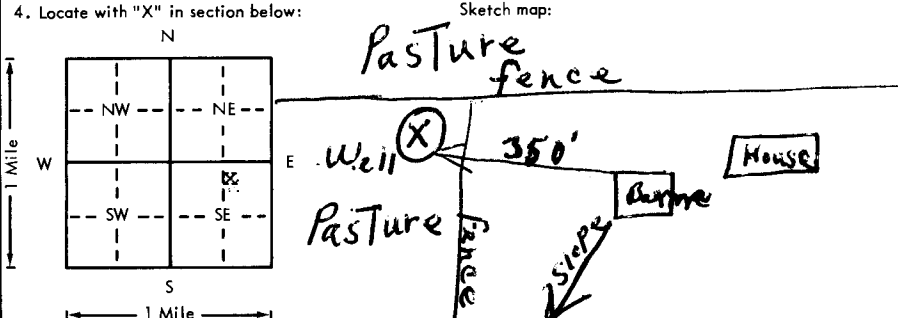


USE TYPEWRITER OR BALL POINT PEN-PRESS FIRMLY, PRINT CLEARLY.

WATER WELL RECORD
KSA 82a-1201-1215

Kansas Department of Health and Environment-Division of Environment
(Water well Contractors)
Topeka, Kansas 66620

| | | | | | |
|---|--|---|--|-------------------------------------|------------------------------|
| 1. Location of well: | County COWLEY | Fraction NW 1/4 NE 1/4 SE 1/4 | Section number 33 | Township number T XX 32 S | Range number R 5 E |
| 2. Distance and direction from nearest town or city: 5 miles east; 1 1/2 miles south of Winfield, Kansas Street address of well location if in city: | | | 3. Owner of well: Roger Bolander R.R. or street: 705 E. 15th City, state, zip code: Winfield, Kansas 67156 | | |
| 4. Locate with "X" in section below:  | | | 6. Bore hole dia. 10 in. Completion date 7-25-77 Well depth 120 ft. | | |
| 5. Type and color of material | | | 7. <input checked="" type="checkbox"/> Cable tool <input type="checkbox"/> Rotary <input type="checkbox"/> Driven <input type="checkbox"/> Dug <input type="checkbox"/> Hollow rod <input type="checkbox"/> Jetted <input type="checkbox"/> Bored <input type="checkbox"/> Reverse rotary | | |
| Top Soil | | | 8. Use: <input checked="" type="checkbox"/> Domestic <input type="checkbox"/> Public supply <input type="checkbox"/> Industry <input type="checkbox"/> Irrigation <input type="checkbox"/> Air conditioning <input type="checkbox"/> Stock <input type="checkbox"/> Lawn <input type="checkbox"/> Oil field water <input type="checkbox"/> Other | | |
| White Lime | | | 9. Casing: Material plts Height: Above or below Threaded <input type="checkbox"/> Welded <input type="checkbox"/> Surface 24 in. RMP <input type="checkbox"/> PVC <input type="checkbox"/> Weight 300 lbs./ft. Dia. 5" in. to 120 ft. depth Wall Thickness: inches or Dia. <input type="checkbox"/> in. to <input type="checkbox"/> ft. depth gage No. 200 | | |
| Blue Shale | | | 10. Screen: Manufacturer's name Jess & Lowell Type plastic Dia. 5" <input checked="" type="checkbox"/> Slat gauze 1/16 Length 10 ft. Set between 120 ft. and 110 ft. <input type="checkbox"/> ft. and <input type="checkbox"/> ft. Gravel pack? yes Size range of material 5/8" max. | | |
| Red Bed | | | 11. Static water level: <input type="checkbox"/> mo./day/yr. 31 ft. below land surface Date 7/25/77 | | |
| Blue Shale | | | 12. Pumping level below land surfaces: Bailer Test <input type="checkbox"/> ft. after <input type="checkbox"/> hrs. pumping <input type="checkbox"/> g.p.m. <input type="checkbox"/> ft. after <input type="checkbox"/> hrs. pumping <input type="checkbox"/> g.p.m. Estimated maximum yield 1/2 g.p.m. | | |
| | | | 13. Water sample submitted: <input type="checkbox"/> mo./day/yr. <input type="checkbox"/> Yes <input checked="" type="checkbox"/> No Date <input type="checkbox"/> | | |
| | | | 14. Well head completion: <input type="checkbox"/> Pitless adapter 24 Inches above grade | | |
| | | | 15. Well grouted? Yes With: <input checked="" type="checkbox"/> Neat cement <input type="checkbox"/> Bentonite <input type="checkbox"/> Concrete Depth: From 0 ft. to 10 ft. | | |
| | | | 16. Nearest source of possible contamination: unknown ft. <input type="checkbox"/> Direction <input type="checkbox"/> Type <input type="checkbox"/> Well disinfected upon completion? <input checked="" type="checkbox"/> Yes <input type="checkbox"/> No | | |
| | | | 17. Pump: <input checked="" type="checkbox"/> Not installed Manufacturer's name <input type="checkbox"/> Model number <input type="checkbox"/> HP <input type="checkbox"/> Volts <input type="checkbox"/> Length of drop pipe <input type="checkbox"/> ft. capacity <input type="checkbox"/> g.p.m. Type: <input type="checkbox"/> Submersible <input type="checkbox"/> Turbine <input type="checkbox"/> Jet <input type="checkbox"/> Reciprocating <input type="checkbox"/> Centrifugal <input type="checkbox"/> Other | | |
| (Use a second sheet if needed) | | | | | |
| 18. Elevation: Topography: <input type="checkbox"/> Hill <input type="checkbox"/> Slope <input checked="" type="checkbox"/> Upland <input type="checkbox"/> Valley | 19. Remarks: Concrete slab to be installed by customer at surface of ground. He knows this is a regulation. <i>Roger Bolander</i> | | 20. Water well contractor's certification: This well was drilled under my jurisdiction and this report is true to the best of my knowledge and belief. Ronal Heffron Drilling #113 Business name Route 3, Winfield, Ks. 67156 License No. <input type="checkbox"/> Address Ronal Heffron Signed <i>Ronal Heffron</i> Authorized representative Date 7/25/77 | | |

T 32
R 5
E
W
33
NW
SE
1/4
1/4
1/4
1/4

Forward the white, blue and pink copies to the Department of Health and Environment

Form WWC-5