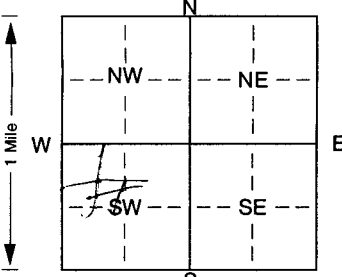


1] LOCATION OF WATER WELL: Fraction SE 1/4 NW 1/4 SW 1/4 Section Number 12 Township Number T 32 S Range Number R 6 E  
 County: Cowley  
 Distance and direction from nearest town or city street address of well if located within city? 3-mile S + 2 East of Barden  
 2] WATER WELL OWNER: Chad Cron Windfield Kan 67156  
 RR#, St. Address, Box # : 2618 Morning View Board of Agriculture, Division of Water Resources  
 City, State, ZIP Code Application Number:

3] LOCATE WELL'S LOCATION WITH AN "X" IN SECTION BOX:  
  
 4] DEPTH OF COMPLETED WELL: 168 ft. ELEVATION: ..... ft.  
 Depth(s) Groundwater Encountered ..... ft. 2. .... ft. 3. .... ft.  
 WELL'S STATIC WATER LEVEL 30 ft. below land surface measured on mo/day/yr .....  
 Pump test data: Well water was ..... ft. after ..... hours pumping ..... gpm  
 Est. Yield 2 gpm Well water was ..... ft. after ..... hours pumping ..... gpm  
 Bore Hole Diameter: 9 1/2 in. to ..... ft., and ..... in. to ..... ft.  
 WELL WATER TO BE USED AS: 5 Public water supply 8 Air conditioning 11 Injection well  
 Domestic 3 Feedlot 6 Oil field water supply 9 Dewatering 12 Other (Specify below)  
 Irrigation 4 Industrial 7 Domestic (lawn & garden) 10 Monitoring well  
 Was a chemical/bacteriological sample submitted to Department? Yes. .... No. ; If yes, mo/day/yrs sample was submitted  
 Water Well Disinfected? Yes ..... No

5] TYPE OF BLANK CASING USED: 5 Wrought iron 8 Concrete tile CASING JOINTS: Glued.  Clamped. ....  
 1 Steel 3 RMP (SR) 6 Asbestos-Cement 9 Other (specify below) Welded .....  
 2 PVC 4 ABS 7 Fiberglass ..... Threaded .....  
 Blank casing diameter ..... in. to 60 ft., Dia ..... in. to ..... ft., Dia ..... in. to ..... ft.  
 Casing height above land surface: 18 in., weight ..... lbs./ft. Wall thickness or gauge No. 2 1/4  
 TYPE OF SCREEN OR PERFORATION MATERIAL: 7 PVC 10 Asbestos-cement  
 1 Steel 3 Stainless steel 5 Fiberglass 8 RMP (SR) 11 Other (specify) .....  
 2 Brass 4 Galvanized steel 6 Concrete tile 9 ABS 12 None used (open hole)  
 SCREEN OR PERFORATION OPENINGS ARE: 5 Gauzed wrapped 8 Saw cut 11 None (open hole)  
 1 Continuous slot 3 Mill slot 6 Wire wrapped 9 Drilled holes  
 2 Louvered shutter 4 Key punched 7 Torch cut 10 Other (specify) ..... ft.  
 SCREEN-PERFORATED INTERVALS: From 60 ft. to 168 ft., From ..... ft. to ..... ft.  
 From ..... ft. to ..... ft., From ..... ft. to ..... ft.  
 GRAVEL PACK INTERVALS: From ..... ft. to ..... ft., From ..... ft. to ..... ft.  
 From ..... ft. to ..... ft., From ..... ft. to ..... ft.

6] GROUT MATERIAL: 1 Neat cement 2 Cement grout  Bentonite 4 Other .....  
 Grout Intervals: From 3 ft. to 23 ft., From ..... ft. to ..... ft., From ..... ft. to ..... ft.  
 What is the nearest source of possible contamination:  
 1 Septic tank 4 Lateral lines 7 Pit privy 10 Livestock pens 14 Abandoned water well  
 2 Sewer lines 5 Cess pool  Sewage lagoon 11 Fuel storage 15 Oil well/Gas well  
 3 Watertight sewer lines 6 Seepage pit 9 Feedyard 12 Fertilizer storage 16 Other (specify below)  
 13 Insecticide storage  
 Direction from well? W How many feet? 175

FROM	TO	LITHOLOGIC LOG	FROM	TO	PLUGGING INTERVALS
0	3	soil			
3	15	rock			
15	20	clay			
20	168	shale + lime			

RECEIVED  
 NOV 24 2004  
 BUREAU OF WATER

7] CONTRACTOR'S OR LANDOWNER'S CERTIFICATION: This water well was  constructed, (2) reconstructed, or (3) plugged under my jurisdiction and was completed on (mo/day/year) 10/24/04 and this record is true to the best of my knowledge and belief. Kansas Water Well Contractor's Licence No. 75 This Water Well Record was completed on (mo/day/yr) 11/22/04 under the business name of Winter Well Drilling by (signature) Charles Winter