

Corrected

KOLAR

WATER WELL RECORD Form WWC-5


Original Record Correction Change in Well Use

Division of Water Resources App. No.

Well ID

1 LOCATION OF WATER WELL: County: Sumner Fraction NW 1/4 SW 1/4 SE 1/4 SW 1/4 Section Number 4 Township Number T 33 S Range Number R 1 E W

2 WELL OWNER: Last Name: Larsen First: John Street or Rural Address where well is located (if unknown, distance and direction from nearest town or intersection): 1/2 mile west of Hydraulic on East 60th St. South Sumner County

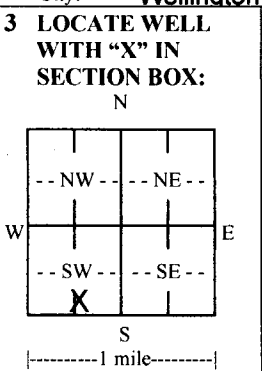

3 LOCATE WELL WITH 'X' IN SECTION BOX: 4 DEPTH OF COMPLETED WELL: 80 ft. Depth(s) Groundwater Encountered: 1) 10 ft. 2) ... 3) ... 4) Dry Well WELL'S STATIC WATER LEVEL: 70 ft. below land surface, measured on (mo-day-yr) 07/09/2018

5 Latitude: 37.20469 Longitude: 97.32454 Datum: WGS 84 Source for Latitude/Longitude: GPS (unit make/model) Land Survey Topographic Map Online Mapper: 6 Elevation: 1166 ft. Ground Level TOC Source: Land Survey GPS Topographic Map Other KOLAR

7 WELL WATER TO BE USED AS: 1. Domestic: Household Lawn & Garden Livestock Irrigation Feedlot Industrial 2. Public Water Supply: well ID 3. Dewatering: how many wells? 4. Aquifer Recharge: well ID 5. Monitoring: well ID 6. Environmental Remediation: well ID Air Sparge Soil Vapor Extraction Recovery Injection 7. Oil Field Water Supply: lease 8. Test Hole: well ID Cased Uncased Geotechnical 9. Geothermal: how many bores? a) Closed Loop Horizontal Vertical b) Open Loop Surface Discharge Inj. of Water 10. Other (specify):

Was a chemical/bacteriological sample submitted to KDHE? Yes No If yes, date sample was submitted: Water well disinfected? Yes No

8 TYPE OF CASING USED: Steel PVC Other CASING JOINTS: Glued Clamped Welded Threaded Casing diameter 5 in. to 60 ft., Diameter in. to ft., Diameter in. to ft. Casing height above land surface 12 in. Weight lbs./ft. Wall thickness or gauge No. 214

TYPE OF SCREEN OR PERFORATION MATERIAL: Steel Stainless Steel Fiberglass PVC Other (Specify) SCREEN OR PERFORATION OPENINGS ARE: Continuous Slot Mill Slot Gauze Wrapped Torch Cut Drilled Holes Other (Specify) Louvered Shutter Key Punched Wire Wrapped Saw Cut None (Open Hole) SCREEN-PERFORATED INTERVALS: From 23 ft. to 80 ft. GRAVEL PACK INTERVALS: From 23 ft. to 80 ft.

RECEIVED FEB 11 2019

BUREAU OF WATER

9 GROUT MATERIAL: Neat cement Cement grout Bentonite Other Grout Intervals: From 3 ft. to 23 ft. Nearest source of possible contamination: No potential source of contamination within 200 ft. Septic Tank Lateral Lines Pit Privy Livestock Pens Insecticide Storage Sewer Lines Cess Pool Sewage Lagoon Fuel Storage Abandoned Water Well Watertight Sewer Lines Seepage Pit Feedyard Fertilizer Storage Oil Well/Gas Well Other (Specify) None Direction from well? 0 Distance from well? 0

LITHOLOGIC LOG table with columns: 10 FROM, TO, LITHOLOGIC LOG, FROM, TO, LITHO. LOG (cont.) or PLUGGING INTERVALS. Rows: 0-20 Shale, 20-30 Shale, 30-35 Shale, 35-45 Sand & Shale, 45-60 Shale, 60-80 Shale

Notes:

11 CONTRACTOR'S OR LANDOWNER'S CERTIFICATION: This water well was constructed, reconstructed, or plugged under my jurisdiction and was completed on (mo-day-year) 07/09/2018 and this record is true to the best of my knowledge and belief. Kansas Water Well Contractor's License No. 818 This Water Well Record was completed on (mo-day-year) 07/09/2018 under the business name of Hobbs Mechanical, Inc.