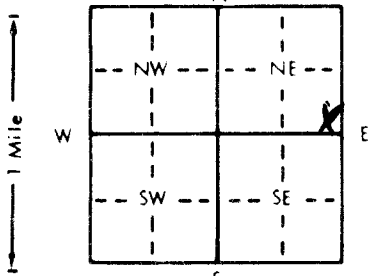


1 LOCATION OF WATER WELL: Fraction E 1/4 E 1/4 NE 1/4 Section Number 10 Township Number T 33 S Range Number R 12 E
 County: CHAUTAUGUA

Distance and direction from nearest town or city street address of well if located within city?
12 miles N. E. of SADAN, KS ON SADAN CUT OFF RD TO INTERSTATE 65

2 WATER WELL OWNER: KEITH REDDINGER
 RR#, St. Address, Box #: RR 2 - 89
 City, State, ZIP Code: SADAN, KS 67261
 Board of Agriculture, Division of Water Resources
 Application Number:

3 LOCATE WELL'S LOCATION WITH AN "X" IN SECTION BOX:


4 DEPTH OF COMPLETED WELL: 78 ft. ELEVATION:
 Depth(s) Groundwater Encountered: 65 ft.
 WELL'S STATIC WATER LEVEL: 10 ft. below land surface measured on mo/day/yr 1-10-98
 Pump test data: Well water was _____ ft. after _____ hours pumping _____ gpm
 Est. Yield 3-5 gpm: Well water was _____ ft. after _____ hours pumping _____ gpm
 Bore Hole Diameter: 8 in. to _____ ft. and _____ in. to _____ ft.
 WELL WATER TO BE USED AS:
 1 Domestic 3 Feedlot 6 Oil field water supply 9 Dewatering 12 Other (Specify below)
 2 Irrigation 4 Industrial 7 Lawn and garden only 10 Monitoring well
 Was a chemical/bacteriological sample submitted to Department? Yes _____ No If yes, mo/day/yr sample was submitted _____
 Water Well Disinfected? Yes No _____

5 TYPE OF BLANK CASING USED:
 1 Steel 3 RMP (SR) 6 Asbestos-Cement 9 Other (specify below)
 2 PVC 4 ABS 7 Fiberglass 8 Concrete tile CASING JOINTS: Glued Clamped Welded Threaded
 Blank casing diameter: 5 in. to 78 ft. Dia _____ in. to _____ ft. Dia _____ in. to _____ ft.
 Casing height above land surface: 18" in. weight SPR 26 lbs. ft. Wall thickness or gauge No. _____
 TYPE OF SCREEN OR PERFORATION MATERIAL:
 1 Steel 3 Stainless steel 5 Fiberglass 7 PVC 10 Asbestos-cement
 2 Brass 4 Galvanized steel 6 Concrete tile 8 RMP (SR) 11 Other (specify) _____
 12 None used (open hole)
 SCREEN OR PERFORATION OPENINGS ARE:
 1 Continuous slot 3 Mill slot 6 Wire wrapped 9 Drilled holes
 2 Louvered shutter 4 Key punched 7 Torch cut 10 Other (specify) _____
 SCREEN-PERFORATED INTERVALS: From 78 ft. to 58 ft. From _____ ft. to _____ ft.
 GRAVEL PACK INTERVALS: From 78 ft. to 22 ft. From _____ ft. to _____ ft.

6 GROUT MATERIAL: 1 Neat cement 2 Cement grout 3 Bentonite 4 Other _____
 Grout intervals: From 22 ft. to 20 ft. From 20 ft. to 0 ft. From _____ ft. to _____ ft.
 What is the nearest source of possible contamination:
 1 Septic tank 4 Lateral lines 7 Pit privy 10 Livestock pens 14 Abandoned water well
 2 Sewer lines 5 Cess pool 8 Sewage lagoon 11 Fuel storage 15 Oil well/Gas well
 3 Watertight sewer lines 6 Seepage pit 9 Feedyard 12 Fertilizer storage 16 Other (specify below) _____
 13 Insecticide storage
 Direction from well? _____ How many feet? 200+ feet

FROM	TO	LITHOLOGIC LOG	FROM	TO	PLUGGING INTERVALS
0	15	SANDSTONE			
15	65	SHALE GRAY			
65	70	LIME			
70	78	SHALE GRAY			

7 CONTRACTOR'S OR LANDOWNER'S CERTIFICATION: This water well was (1) constructed, (2) reconstructed, or (3) plugged under my jurisdiction and was completed on (mo/day/year) 1-21-98 and this record is true to the best of my knowledge and belief. Kansas Water Well Contractor's License No. 501 This Water Well Record was completed on (mo/day/yr) 1-21-98 under the business name of CADILLAC WATER WELL SERVICE by (signature) Kenneth M. Calloway