


1 LOCATION OF WATER WELL: County: Chautauqua Fraction: NE 1/4 NE 1/4 NW 1/4 Section Number: 26 Township Number: T 33 S Range Number: R 12 EW

Distance and direction from nearest town or city street address of well if located within city?

6 1/2 Mi. from Sedan, Kan & 2 mi North

2 WATER WELL OWNER: Homer English Board of Agriculture, Division of Water Resources
 RR#, St. Address, Box #: Rt 2 Sedan Kan 67361 Application Number:

3 LOCATE WELL'S LOCATION WITH AN "X" IN SECTION BOX:

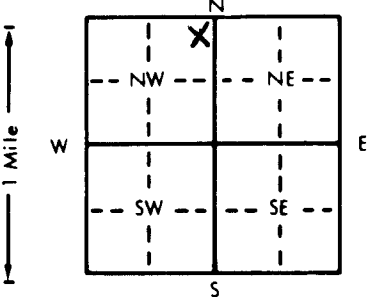

4 DEPTH OF COMPLETED WELL: 250 ft. ELEVATION:

Depth(s) Groundwater Encountered 1. 200 ft. 2. _____ ft. 3. _____ ft.

WELL'S STATIC WATER LEVEL 107 ft. below land surface measured on mo/day/yr Oct, 16, 81

Pump test data: Well water was _____ ft. after _____ hours pumping _____ gpm

Est. Yield 1/2 gpm: Well water was _____ ft. after _____ hours pumping _____ gpm

Bore Hole Diameter 9 in. to 12 ft., and 6 in. to 250 ft.

WELL WATER TO BE USED AS: 5 Public water supply 8 Air conditioning 11 Injection well

1 Domestic 3 Feedlot 6 Oil field water supply 9 Dewatering 12 Other (Specify below)

2 Irrigation 4 Industrial 7 Lawn and garden only 10 Observation well

Was a chemical/bacteriological sample submitted to Department? Yes _____ No If yes, mo/day/yr sample was submitted

Water Well Disinfected? Yes No

5 TYPE OF BLANK CASING USED: 5 Wrought iron 8 Concrete tile CASING JOINTS: Glued _____ Clamped _____

1 Steel 3 RMP (SR) 6 Asbestos-Cement 9 Other (specify below) Welded _____

2 PVC 4 ABS 7 Fiberglass _____ Threaded _____

Blank casing diameter 6 in. to 40 ft., Dia _____ in. to _____ ft., Dia _____ in. to _____ ft.

Casing height above land surface 12 in., weight _____ lbs./ft. Wall thickness or gauge No. SDR 21

TYPE OF SCREEN OR PERFORATION MATERIAL: 7 PVC 10 Asbestos-cement

1 Steel 3 Stainless steel 5 Fiberglass 8 RMP (SR) 11 Other (specify) _____

2 Brass 4 Galvanized steel 6 Concrete tile 9 ABS 12 None used (open hole)

SCREEN OR PERFORATION OPENINGS ARE: 5 Gauzed wrapped 8 Saw cut 11 None (open hole)

1 Continuous slot 3 Mill slot 6 Wire wrapped 9 Drilled holes

2 Louvered shutter 4 Key punched 7 Torch cut 10 Other (specify) _____

SCREEN-PERFORATED INTERVALS: From _____ ft. to _____ ft., From _____ ft. to _____ ft.

GRAVEL PACK INTERVALS: From _____ ft. to _____ ft., From _____ ft. to _____ ft.

6 GROUT MATERIAL: 1 Neat cement 2 Cement grout 3 Bentonite 4 Other _____

Grout Intervals: From 2 ft. to 12 ft., From _____ ft. to _____ ft., From _____ ft. to _____ ft.

What is the nearest source of possible contamination: 10 Livestock pens 14 Abandoned water well

1 Septic tank 4 Lateral lines 7 Pit privy 11 Fuel storage 15 Oil well/Gas well

2 Sewer lines 5 Cess pool 8 Sewage lagoon 12 Fertilizer storage 16 Other (specify below)

3 Watertight sewer lines 6 Seepage pit 9 Feedyard 13 Insecticide storage NONE KNOWN

Direction from well? How many feet?

FROM	TO	LITHOLOGIC LOG	FROM	TO	LITHOLOGIC LOG
0	1	Soil			
1	32	Yellow Clay			
32	48	Gray Shale			
48	78	Hard Shale			
78	117	Gray Shale			
117	124	Black Shale			
124	143	Gray Shale			
143	145	Lime			
145	160	Gray Shale			
160	170	Sandy Shale			
170	180	Gray Shale			
180	218	Sandy Shale			
218	250	Gray Shale			

7 CONTRACTOR'S OR LANDOWNER'S CERTIFICATION: This water well was (1) constructed, (2) reconstructed, or (3) plugged under my jurisdiction and was completed on (mo/day/year) Oct, 17, 1981 and this record is true to the best of my knowledge and belief. Kansas

Water Well Contractor's License No. 3931 This Water Well Record was completed on (mo/day/yr) Nov 3, 1981

under the business name of Country Water by (signature) Melvin Ray Wishes

INSTRUCTIONS: Use typewriter or ball point pen. PLEASE PRESS FIRMLY and PRINT clearly. Please fill in blanks, underline or circle the correct answers. Send top three copies to Kansas Department of Health and Environment, Division of Environment, Environmental Geology Section, Topeka, KS 66620. Send one to WATER WELL OWNER and retain one for your records.

OFFICE USE ONLY T 33 R 12 EW SEC. 26 NE 1/4 NE 1/4 NW 1/4