


1 LOCATION OF WATER WELL: County **CHAUTAUGUA** Fraction **SW 1/4 SW 1/4 SW 1/4** Section Number **33** Township Number **T 33 S** Range Number **R 12 E**

Distance and direction from nearest town or city street address of well if located within city? **2 MILES 1/2 MILES NORTH OF CANEY, KS**

2 WATER WELL OWNER: **PHIL MILLIKEN**
 RR#, St. Address, Box #: **610 W 5**
 City, State, ZIP Code: **CANEY, KS**
 Board of Agriculture, Division of Water Resources
 Application Number:

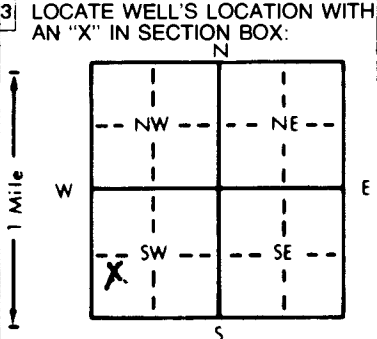

4 DEPTH OF COMPLETED WELL: **130** ft. ELEVATION:
 Depth(s) Groundwater Encountered: **999 DRY** ft. 2. ft. 3.
 WELL'S STATIC WATER LEVEL: ft. below land surface measured on mo/day/yr
 Pump test data: Well water was ft. after hours pumping gpm
 Est. Yield gpm: Well water was ft. after hours pumping gpm
 Bore Hole Diameter: **8** in. to **130** ft. and in. to ft.
 WELL WATER TO BE USED AS:
 5 Public water supply 8 Air conditioning 11 Injection well
 1 Domestic 3 Feedlot 6 Oil field water supply 9 Dewatering 12 Other (Specify below)
 2 Irrigation 4 Industrial 7 Lawn and garden only 10 Monitoring well
 Was a chemical/bacteriological sample submitted to Department? Yes.....No **X**.....; If yes, mo/day/yr sample was submitted
 Water Well Disinfected? Yes **X** No **X**

5 TYPE OF BLANK CASING USED:
 1 Steel 3 RMP (SR) 5 Wrought iron 8 Concrete tile CASING JOINTS: Glued Clamped
 2 PVC 4 ABS 6 Asbestos-Cement 9 Other (specify below) Welded
 7 Fiberglass **NOUE** Threaded.....
 Blank casing diameter ϕ in. to ft., Dia in. to ft., Dia in. to ft.
 Casing height above land surface ϕ in., weight lbs./ft. Wall thickness or gauge No.
 TYPE OF SCREEN OR PERFORATION MATERIAL:
 1 Steel 3 Stainless steel 5 Fiberglass 7 PVC 10 Asbestos-cement
 2 Brass 4 Galvanized steel 6 Concrete tile 8 RMP (SR) 11 Other (specify) **NA**
 9 ABS 12 None used (open hole)
 SCREEN OR PERFORATION OPENINGS ARE:
 1 Continuous slot 3 Mill slot 5 Gauzed wrapped 8 Saw cut 11 None (open hole)
 2 Louvered shutter 4 Key punched 6 Wire wrapped 9 Drilled holes
 7 Torch cut 10 Other (specify) **NA**
 SCREEN-PERFORATED INTERVALS: From **NA** ft. to **NA** ft., From ft. to ft.
 From ft. to ft., From ft. to ft.
 GRAVEL PACK INTERVALS: From ft. to ft., From ft. to ft.
 From ft. to ft., From ft. to ft.

6 GROUT MATERIAL: ~~1 Cement~~ 2 Cement grout 3 Bentonite 4 Other
 Grout Intervals: From **130** ft. to **120** ft., From **10** ft. to **2** ft., From ft. to ft.
 What is the nearest source of possible contamination:
 1 Septic tank 4 Lateral lines 7 Pit privy 10 Livestock pens 14 Abandoned water well
 2 Sewer lines 5 Cess pool 8 Sewage lagoon 11 Fuel storage 15 Oil well/Gas well
 3 Watertight sewer lines 6 Seepage pit 9 Feedyard 12 Fertilizer storage 16 Other (specify below)
 13 Insecticide storage
 Direction from well? How many feet?

FROM	TO	LITHOLOGIC LOG	FROM	TO	PLUGGING INTERVALS
0	20	yellow clay	130	120	Cement NEAT
20	64	gray clay	120	110	silt
64	80	lime	110	100	Cement
80	105	shale gray	10	2	Cement NEAT
105	120	lime	3	0	silt
120	130	sand white			

7 CONTRACTOR'S OR LANDOWNER'S CERTIFICATION: This water well was (1) constructed, (2) reconstructed, or (3) plugged under my jurisdiction and was completed on (mo/day/year) **9/19/93** and this record is true to the best of my knowledge and belief. Kansas Water Well Contractor's License No. **501** This Water Well Record was completed on (mo/day/yr) under the business name of **Collier WATER WELL SERVICE** by (signature) **Jenneth M Collier**

OFFICE USE ONLY
T
R
EW
SEC