


1 LOCATION OF WATER WELL: County: MONTGOMERY Fraction: SW 1/4 SW 1/4 SW 1/4 Section Number: 8 Township Number: T 33 S Range Number: R 14 E/W

Distance and direction from nearest town or city street address of well if located within city?
INDEPENDENCE 2 mi. E/W EST TO 75th WAY 2 mi. 7 mi. W. 1 mi. S. 3/4 W. N.E

2 WATER WELL OWNER: ROBERT WHITLUM
 RR#, St. Address, Box #: RR Board of Agriculture, Division of Water Resources
 City, State, ZIP Code: INDEPENDENCE, KS Application Number:

3 LOCATE WELL'S LOCATION WITH AN "X" IN SECTION BOX:

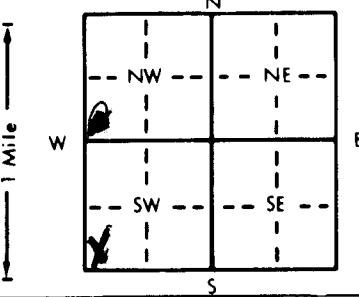

4 DEPTH OF COMPLETED WELL: 100 ft. ELEVATION:

Depth(s) Groundwater Encountered 1. DRY ft. 2. ft. 3. ft.
 WELL'S STATIC WATER LEVEL DRY ft. below land surface measured on mo/day/yr
 Pump test data: Well water was ft. after hours pumping gpm
 Est. Yield 0 gpm: Well water was ft. after hours pumping gpm
 Bore Hole Diameter: 8 in. to 100 ft., and in. to ft.
 WELL WATER TO BE USED AS:
 1 Domestic (circled) 3 Feedlot 6 Oil field water supply 9 Dewatering 12 Other (Specify below)
 2 Irrigation 4 Industrial 7 Lawn and garden only 10 Monitoring well
 Was a chemical/bacteriological sample submitted to Department? Yes No X If yes, mo/day/yr sample was submitted
 Water Well Disinfected? Yes X No

5 TYPE OF BLANK CASING USED:
 1 Steel 3 RMP (SR) 5 Wrought iron 8 Concrete tile CASING JOINTS: Glued Clamped
 2 PVC 4 ABS 6 Asbestos-Cement 9 Other (specify below) Welded
 7 Fiberglass Threaded

Blank casing diameter: 5 in. Dia. in. to ft. Dia. in. to ft.
 Casing height above land surface: 48 in., weight lbs./ft. Wall thickness or gauge No.

TYPE OF SCREEN OR PERFORATION MATERIAL:
 1 Steel 3 Stainless steel 5 Fiberglass 7 PVC 10 Asbestos-cement
 2 Brass 4 Galvanized steel 6 Concrete tile 8 RMP (SR) 11 Other (specify) NA
 12 None used (open hole)

SCREEN OR PERFORATION OPENINGS ARE:
 1 Continuous slot 3 Mill slot 5 Gauzed wrapped 8 Saw cut 11 None (open hole)
 2 Louvered shutter 4 Key punched 6 Wire wrapped 9 Drilled holes
 7 Torch cut 10 Other (specify) NA

SCREEN-PERFORATED INTERVALS: From NA ft. to NA ft., From ft. to ft.
 From ft. to ft., From ft. to ft.

GRAVEL PACK INTERVALS: From ft. to ft., From ft. to ft.
 From ft. to ft., From ft. to ft.

6 GROUT MATERIAL: 1 Neat cement 2 Cement grout 3 Bentonite 4 Other
 Grout Intervals: From 10 ft. to 4 ft., From ft. to ft., From ft. to ft.

What is the nearest source of possible contamination:
 1 Septic tank 4 Lateral lines 7 Pit privy 10 Livestock pens 14 Abandoned water well
 2 Sewer lines 5 Cess pool 8 Sewage lagoon 11 Fuel storage 15 Oil well/Gas well
 3 Watertight sewer lines 6 Seepage pit 9 Feedyard 12 Fertilizer storage 16 Other (specify below)
 13 Insecticide storage

Direction from well? How many feet?

FROM	TO	LITHOLOGIC LOG	FROM	TO	PLUGGING INTERVALS
0	22	SANDSTONE + yellow clay	100	80	SILT + P
22	100	GRAY SHALE	80	84	CEMENT NEAT CEMENT NEAT
			84	0	SILT

DRY + plugged

plugged DRY

7 CONTRACTOR'S OR LANDOWNER'S CERTIFICATION: This water well was (1) constructed, (2) reconstructed, or (3) plugged under my jurisdiction and was completed on (mo/day/year) 6-28-93 5/25/93 and this record is true to the best of my knowledge and belief. Kansas Water Well Contractor's License No. 501 This Water Well Record was completed on (mo/day/yr) 6-7-93 under the business name of Callier Water Well Service by (signature) Jenneth Callier