


1 LOCATION OF WATER WELL: County: Montgomery Fraction: SW 1/4 NW 1/4 NE 1/4 Section Number: 29 Township Number: T 33 S Range Number: R 14 E/W

Distance and direction from nearest town or city street address of well if located within city? 1/4 mile west of Wayside T 1 3/4 mile north + 1/2 west

2 WATER WELL OWNER: RR#, St. Address, Box #: Guy Mantooth RRI Navana Kan. 67347 Board of Agriculture, Division of Water Resources Application Number:

3 LOCATE WELL'S LOCATION WITH AN "X" IN SECTION BOX:

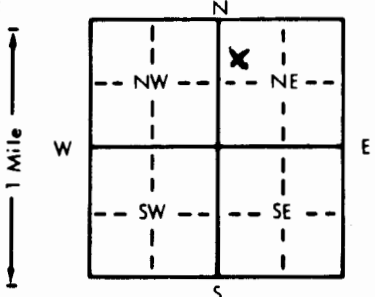

4 DEPTH OF COMPLETED WELL: 145 ft. ELEVATION: WELL'S STATIC WATER LEVEL: 20 ft. below land surface measured on mo/day/yr Feb 12, 83. Pump test data: Well water was ... gpm. Bore Hole Diameter: 10 in. to 10 in. and 6 in. to 145 ft. WELL WATER TO BE USED AS: 5 Public water supply, 8 Air conditioning, 11 Injection well, 12 Other (Specify below). Was a chemical/bacteriological sample submitted to Department? Yes No. Water Well Disinfected? Yes No.

5 TYPE OF BLANK CASING USED: 1 Steel, 2 PVC, 3 RMP (SR), 4 ABS, 5 Wrought iron, 6 Asbestos-Cement, 7 Fiberglass, 8 Concrete tile, 9 Other (specify below), 10 Asbestos-cement. Blank casing diameter: 6 in. to 12 in. Dia. Casing height above land surface: 45 in., weight lbs./ft. Wall thickness or gauge No. SDR 26.

TYPE OF SCREEN OR PERFORATION MATERIAL: 1 Steel, 2 Brass, 3 Stainless steel, 4 Galvanized steel, 5 Fiberglass, 6 Concrete tile, 7 PVC, 8 RMP (SR), 9 ABS, 10 Asbestos-cement, 11 Other (specify), 12 None used (open hole).

SCREEN OR PERFORATION OPENINGS ARE: 1 Continuous slot, 2 Louvered shutter, 3 Mill slot, 4 Key punched, 5 Gauzed wrapped, 6 Wire wrapped, 7 Torch cut, 8 Saw cut, 9 Drilled holes, 10 Other (specify), 11 None (open hole).

SCREEN-PERFORATED INTERVALS: From ... ft. to ... ft. GRAVEL PACK INTERVALS: From ... ft. to ... ft.

6 GROUT MATERIAL: 1 Neat cement, 2 Cement grout, 3 Bentonite, 4 Other. Grout Intervals: From 0 ft. to 10 ft.

What is the nearest source of possible contamination: 1 Septic tank, 2 Sewer lines, 3 Watertight sewer lines, 4 Lateral lines, 5 Cess pool, 6 Seepage pit, 7 Pit privy, 8 Sewage lagoon, 9 Feedyard, 10 Livestock pens, 11 Fuel storage, 12 Fertilizer storage, 13 Insecticide storage, 14 Abandoned water well, 15 Oil well/Gas well-field, 16 Other (specify below).

Direction from well? all sides How many feet?

LITHOLOGIC LOG table with columns FROM, TO, LITHOLOGIC LOG. Entries include Soil (0-2), Clay (2-3), Sand Rock (3-5), Yellow Clay (5-10), Sandy Lime (10-13), Shale (13-70), Lime (70-72), Shale (72-95), Black Shale (95-97), Sandy Shale (97-101), Shale Sand (101-110), Water Sand (110-120), Shale (120-145).

7 CONTRACTOR'S OR LANDOWNER'S CERTIFICATION: This water well was (1) constructed, (2) reconstructed, or (3) plugged under my jurisdiction and was completed on (mo/day/year) Jan 6, 1983 and this record is true to the best of my knowledge and belief. Kansas Water Well Contractor's License No. 393 This Water Well Record was completed on (mo/day/yr) Feb 12, 83 under the business name of Country Water by signature Ray Weber

INSTRUCTIONS: Use typewriter or ball point pen. PLEASE PRESS FIRMLY and PRINT clearly. Please fill in blanks, underline or circle the correct answers. Send top three copies to Kansas Department of Health and Environment, Division of Environment, Environmental Geology Section, Topeka, KS 66620. Send one to WATER WELL OWNER and retain one for your records.

OFFICE USE ONLY T 33 R 14 SW 1/4 NW 1/4 NE 1/4 SEC. 29