


1 LOCATION OF WATER WELL: County: Montgomery Fraction: NW 1/4 SW 1/4 NE 1/4 Section Number: 28 Township Number: T 33 S Range Number: R 15 EW

Distance and direction from nearest town or city street address of well if located within city?
At Independence Municipal Airport - Independence, KS

2 WATER WELL OWNER: U.S. CORPS OF ENGINEERS / City of Independence, KS MW-04
 RR#, St. Address, Box #: 126 N. 6th St
 City, State, ZIP Code: Independence, KS 67301 Board of Agriculture, Division of Water Resources
 Application Number:

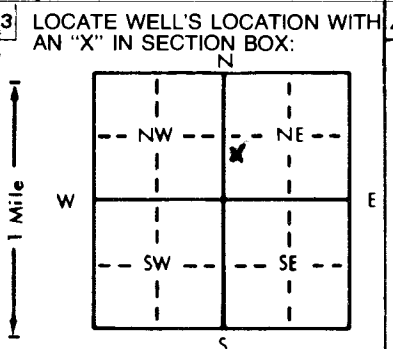

4 DEPTH OF COMPLETED WELL: 21.2 ft. ELEVATION: 819.1
 Depth(s) Groundwater Encountered 1. ? ft. 2. _____ ft. 3. _____ ft.
 WELL'S STATIC WATER LEVEL: 8.02 ft. below land surface measured on mo/day/yr 6-15-96
 Pump test data: Well water was N/A ft. after _____ hours pumping _____ gpm
 Est. Yield N/A gpm: Well water was _____ ft. after _____ hours pumping _____ gpm
 Bore Hole Diameter: 8 in. to 5 ft., and 6 in. to 21.2 ft.
 WELL WATER TO BE USED AS:
 5 Public water supply 8 Air conditioning 11 Injection well
 1 Domestic 3 Feedlot 6 Oil field water supply 9 Dewatering 12 Other (Specify below)
 2 Irrigation 4 Industrial 7 Lawn and garden only 10 Monitoring well
 Was a chemical/bacteriological sample submitted to Department? Yes _____ No ; If yes, mo/day/yr sample was submitted _____
 Water Well Disinfected? Yes _____ No

5 TYPE OF BLANK CASING USED:
 1 Steel 3 RMP (SR) 5 Wrought iron 8 Concrete tile CASING JOINTS: Glued _____ Clamped _____
2 PVC 4 ABS 6 Asbestos-Cement 9 Other (specify below) Welded _____
 7 Fiberglass Threaded
 Blank casing diameter: 2 in. to 5.8 ft., Dia _____ in. to _____ ft., Dia _____ in. to _____ ft.
 Casing height above land surface: 36 in., weight 7 lbs./ft. Wall thickness or gauge No. 188
 TYPE OF SCREEN OR PERFORATION MATERIAL:
 1 Steel 3 Stainless steel 5 Fiberglass 8 RMP (SR) 10 Asbestos-cement
 2 Brass 4 Galvanized steel 6 Concrete tile 9 ABS 12 None used (open hole)
 SCREEN OR PERFORATION OPENINGS ARE:
 1 Continuous slot 3 Mill slot 5 Gauzed wrapped 8 Saw cut 11 None (open hole)
 2 Louvered shutter 4 Key punched 6 Wire wrapped 9 Drilled holes
 7 Torch cut 10 Other (specify) _____
 SCREEN-PERFORATED INTERVALS: From 5.8 ft. to 20.8 ft., From _____ ft. to _____ ft.
 From _____ ft. to _____ ft., From _____ ft. to _____ ft.
 GRAVEL PACK INTERVALS: From 3.8 ft. to 21.2 ft., From _____ ft. to _____ ft.
 From _____ ft. to _____ ft., From _____ ft. to _____ ft.

6 GROUT MATERIAL: 1 Neat cement 2 Cement grout 3 Bentonite 4 Other _____
 Grout Intervals: From 1.8 ft. to 3.8 ft., From _____ ft. to _____ ft., From _____ ft. to _____ ft.
 What is the nearest source of possible contamination: Nothing close - open area
 1 Septic tank 4 Lateral lines 7 Pit privy 10 Livestock pens 14 Abandoned water well
 2 Sewer lines 5 Cess pool 8 Sewage lagoon 11 Fuel storage 15 Oil well/Gas well
 3 Watertight sewer lines 6 Seepage pit 9 Feedyard 12 Fertilizer storage 16 Other (specify below)
 13 Insecticide storage
 Direction from well? _____ How many feet? _____

FROM	TO	LITHOLOGIC LOG	FROM	TO	PLUGGING INTERVALS
0	5	BROWN/GRAY Silty CLAY			
5	11.2	GRAY SHALE			
11.2	19	GRAY Limestone			
19	21.2	GRAY SANDY SHALE			

7 CONTRACTOR'S OR LANDOWNER'S CERTIFICATION: This water well was (1) constructed, (2) reconstructed, or (3) plugged under my jurisdiction and was completed on (mo/day/year) 6-15-96 and this record is true to the best of my knowledge and belief. Kansas Water Well Contractor's License No. 586 This Water Well Record was completed on (mo/day/yr) 7-25-96 under the business name of Roberts Environmental Drilling, INC. by (signature) Charles W. Roberts