


1 LOCATION OF WATER WELL: Fraction SW 1/4 SW 1/4 SE 1/4 Section Number 1 Township Number T 33 S Range Number R 15 EW
 County: Montgomery

Distance and direction from nearest town or city street address of well if located within city?
South on 10th Street 1 mile, 4/10 mile West, So 1 Block, West 1 Block

2 WATER WELL OWNER: Carol Musgrove
 RR#, St. Address, Box #: _____
 City, State, ZIP Code: Independence, KS
 Board of Agriculture, Division of Water Resources
 Application Number: _____

3 LOCATE WELL'S LOCATION WITH AN "X" IN SECTION BOX:

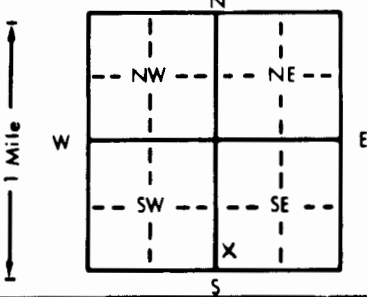

4 DEPTH OF COMPLETED WELL: 125 ft. ELEVATION: _____
 Depth(s) Groundwater Encountered 1. 23 ft. 2. _____ ft. 3. _____ ft.
 WELL'S STATIC WATER LEVEL: 18 ft. below land surface measured on mo/day/yr
 Pump test data: Well water was _____ ft. after _____ hours pumping _____ gpm
 Est. Yield _____ gpm; Well water was _____ ft. after _____ hours pumping _____ gpm
 Bore Hole Diameter: 11 in. to 20 in. and 8 in. to 125 in.
 WELL WATER TO BE USED AS:
 1 Domestic 3 Feedlot 6 Oil field water supply 9 Dewatering 12 Other (Specify below)
 2 Irrigation 4 Industrial 7 Lawn and garden only 10 Observation well
 Was a chemical/bacteriological sample submitted to Department? Yes _____ No If yes, mo/day/yr sample was submitted _____
 Water Well Disinfected? Yes No _____

5 TYPE OF BLANK CASING USED:
 1 Steel 3 RMP (SR) 5 Wrought iron 8 Concrete tile CASING JOINTS: Glued Clamped _____
 2 PVC 4 ABS 6 Asbestos-Cement 9 Other (specify below) Welded _____
 7 Fiberglass Threaded _____
 Blank casing diameter: 8 in. to 20 in. Dia. 6 in. to 105 in. Dia. _____ in. to _____ in. Dia. _____
 Casing height above land surface: 18 in. weight _____ lbs./ft. Wall thickness or gauge No. SOR 26
 TYPE OF SCREEN OR PERFORATION MATERIAL:
 1 Steel 3 Stainless steel 5 Fiberglass 7 PVC 10 Asbestos-cement
 2 Brass 4 Galvanized steel 6 Concrete tile 8 RMP (SR) 11 Other (specify) _____
 12 None used (open hole)
 SCREEN OR PERFORATION OPENINGS ARE:
 1 Continuous slot 3 Mill slot 5 Gauzed wrapped 8 Saw cut 11 None (open hole)
 2 Louvered shutter 4 Key punched 6 Wire wrapped 9 Drilled holes
 7 Torch cut 10 Other (specify) _____
 SCREEN-PERFORATED INTERVALS: From 105 ft. to 125 ft. From _____ ft. to _____ ft.
 GRAVEL PACK INTERVALS: From _____ ft. to _____ ft. From _____ ft. to _____ ft.

6 GROUT MATERIAL: 1 Neat cement 2 Cement grout 3 Bentonite 4 Other _____
 Grout Intervals: From 0 ft. to 20 ft. From _____ ft. to _____ ft. From _____ ft. to _____ ft.
 What is the nearest source of possible contamination:
 1 Septic tank 4 Lateral lines 7 Pit privy 10 Livestock pens 14 Abandoned water well
 2 Sewer lines 5 Cess pool 8 Sewage lagoon 11 Fuel storage 15 Oil well/Gas well
 3 Watertight sewer lines 6 Seepage pit 9 Feedyard 12 Fertilizer storage 16 Other (specify below)
Ford
 Direction from well? South How many feet? 200 Yards

FROM	TO	LITHOLOGIC LOG	FROM	TO	LITHOLOGIC LOG
0	3	Top Soil			
3	23	Brown Clay			
23	46	Shale			
46	49	Sandy Shale			
49	93	Shale			
93	110	Sand/Hard			
110	125	Shale			

7 CONTRACTOR'S OR LANDOWNER'S CERTIFICATION: This water well was (1) constructed, (2) reconstructed, or (3) plugged under my jurisdiction and was completed on (mo/day/year) 8/25/82 and this record is true to the best of my knowledge and belief. Kansas Water Well Contractor's License No. 464 This Water Well Record was completed on (mo/day/year) 9/13/82
 under the business name of Water Well Services Consolidated (signature) [Signature]
 INSTRUCTIONS: Use typewriter or ball point pen. PLEASE PRESS FIRMLY and PRINT clearly. Please fill in blanks, underline or circle the correct answers. Send top three copies to Kansas Department of Health and Environment, Bureau of Water Protection, Topeka, Kansas 66620-7320, Telephone: 913-862-9360. Send one to WATER WELL OWNER and retain one for your records.

OFFICE USE ONLY
 T
 R
 EW
 SEC.