


1 LOCATION OF WATER WELL: Fraction SW 1/4 SW 1/4 SW 1/4 Section Number 12 Township Number T 33 S Range Number R 15. EW
 County: Montgomery
 Distance and direction from nearest town or city street address of well if located within city? 1 mile south of 1 and 1/2 west of Independence KS

2 WATER WELL OWNER: Donald Kenty RR2
 RR#, St. Address, Box # :
 City, State, ZIP Code: Independence KS - 67301 Board of Agriculture, Division of Water Resources Application Number:

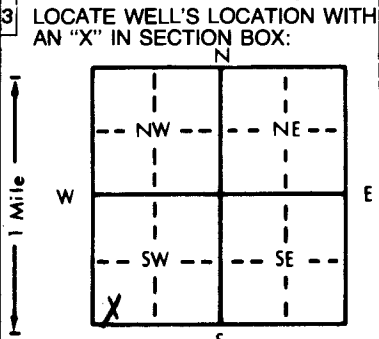

4 DEPTH OF COMPLETED WELL: 92 ft. ELEVATION:
 Depth(s) Groundwater Encountered 1. 18.42 ft. 2. ft. 3. ft.
 WELL'S STATIC WATER LEVEL: 18 ft. below land surface measured on mo/day/yr 7-28/8
 Pump test data: Well water was ft. after hours pumping gpm
 Est. Yield 1 1/2 gpm Well water was ft. after hours pumping gpm
 Bore Hole Diameter: 9 3/8 in. to 14 ft., and 7' in. to 9.2 ft.
 WELL WATER TO BE USED AS: 5 Public water supply 8 Air conditioning 11 Injection well
 Domestic 3 Feedlot 6 Oil field water supply 9 Dewatering 12 Other (Specify below)
 2 Irrigation 4 Industrial 7 Lawn and garden only 10 Observation well
 Was a chemical/bacteriological sample submitted to Department? Yes No ; If yes, mo/day/yr sample was submitted
 Water Well Disinfected? Yes No

5 TYPE OF BLANK CASING USED: 5 Wrought iron 8 Concrete tile CASING JOINTS: Glued Clamped
 1 Steel 3 RMP (SR) 6 Asbestos-Cement 9 Other (specify below) Welded
 PVC 4 ABS 7 Fiberglass Threaded
 Blank casing diameter 6 in. to 20 ft., Dia. in. to ft., Dia. in. to ft.
 Casing height above land surface: 16 in., weight 3.91 lbs./ft. Wall thickness or gauge No. 0.316
 TYPE OF SCREEN OR PERFORATION MATERIAL: 7 PVC 10 Asbestos-cement
 1 Steel 3 Stainless steel 5 Fiberglass 8 RMP (SR) 11 Other (specify)
 2 Brass 4 Galvanized steel 6 Concrete tile 9 ABS 12 None used (open hole)
 SCREEN OR PERFORATION OPENINGS ARE: 5 Gauzed wrapped 8 Saw cut 11 None (open hole)
 1 Continuous slot 3 Mill slot 6 Wire wrapped 9 Drilled holes
 2 Louvered shutter 4 Key punched 7 Torch cut 10 Other (specify)
 SCREEN-PERFORATED INTERVALS: From ft. to ft., From ft. to ft.
 From ft. to ft., From ft. to ft.
 GRAVEL PACK INTERVALS? From None Used ft. to ft., From ft. to ft.
 From ft. to ft., From ft. to ft.

6 GROUT MATERIAL: Neat cement 2 Cement grout 3 Bentonite 4 Other
 Grout Intervals: From 1 ft. to 14 ft., From ft. to ft., From ft. to ft.
 What is the nearest source of possible contamination:
 Septic tank 4 Lateral lines 7 Pit privy 10 Livestock pens 14 Abandoned water well
 2 Sewer lines 5 Cess pool 8 Sewage lagoon 11 Fuel storage 15 Oil well/Gas well
 3 Watertight sewer lines 6 Seepage pit 9 Feedyard 12 Fertilizer storage 16 Other (specify below)
 13 Insecticide storage
 Direction from well? South How many feet? 55 (50' MINIMUM)

FROM	TO	LITHOLOGIC LOG	FROM	TO	LITHOLOGIC LOG
1	2	soil			
3	20	Sand Rock			
21	24	Shale			
25	34	Sand Rock			
35	38	Shale			
39	51	lime rock			
53	74	Shale			
75	89	lime rock			
90	92	Shale			

7 CONTRACTOR'S OR LANDOWNER'S CERTIFICATION: This water well was (1) constructed, (2) reconstructed, or (3) plugged under my jurisdiction and was completed on (mo/day/year) 7-23-81 and this record is true to the best of my knowledge and belief. Kansas Water Well Contractor's License No. 408 This Water Well Record was completed on (mo/day/yr) 7-23-81 under the business name of Prairie Drilling by (signature) Wayne Marshall

INSTRUCTIONS: Use typewriter or ball point pen. PLEASE PRESS FIRMLY and PRINT clearly. Please fill in blanks, underline or circle the correct answers. Send top three copies to Kansas Department of Health and Environment, Division of Environment, Environmental Geology Section, Topeka, KS 66620. Send one to WATER WELL OWNER and retain one for your records.

OFFICE USE ONLY