

1 LOCATION OF WATER WELL:	Fraction	Section Number	Township Number	Range Number
County: <u>Montgomery</u>	<u>NW 1/4 SE 1/4 SE 1/4</u>	<u>21</u>	T <u>33</u> S	R <u>15</u> <u>SW</u>

Distance and direction from nearest town or city street address of well if located within city?

3 S 3 W Independence # 1-B see Enclosed Map

2 WATER WELL OWNER:

RR#, St. Address, Box # :

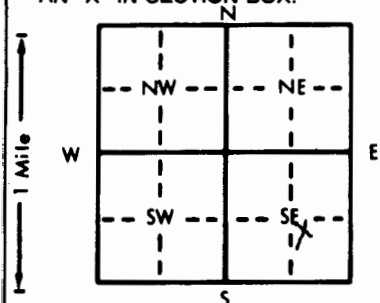
Board of Agriculture, Division of Water Resources

City, State, ZIP Code :

Teledyne, Independence, KS

Application Number:

3 LOCATE WELL'S LOCATION WITH AN "X" IN SECTION BOX:

4 DEPTH OF COMPLETED WELL: 110.3 ft. ELEVATION:

Depth(s) Groundwater Encountered 1. ft. 2. ft. 3. ft.

WELL'S STATIC WATER LEVEL ft. below land surface measured on mo/day/yr

Pump test data: Well water was ft. after hours pumping gpm

Est. Yield gpm: Well water was ft. after hours pumping gpm

Bore Hole Diameter: 5 1/8 in. to 110.3 ft., and in. to ft.

WELL WATER TO BE USED AS: 5 Public water supply 8 Air conditioning 11 Injection well

1 Domestic 3 Feedlot 6 Oil field water supply 9 Dewatering 12 Other (Specify below)

2 Irrigation 4 Industrial 7 Lawn and garden only ☒ Observation wellWas a chemical/bacteriological sample submitted to Department? Yes.....No...X....; If yes, mo/day/yr sample was submitted

Water Well Disinfected? Yes No

5 TYPE OF BLANK CASING USED:

5 Wrought iron

8 Concrete tile

CASING JOINTS: Glued Clamped

1 Steel

3 RMP (SR)

6 Asbestos-Cement

9 Other (specify below)

Welded

☒ 2 PVC

4 ABS

7 Fiberglass

Threaded...XBlank casing diameter 2" in. to 100.3 ft., Dia. in. to ft., Dia. in. to ft.Casing height above land surface 2.75 in., weight lbs./ft. Wall thickness or gauge No. 0.40

TYPE OF SCREEN OR PERFORATION MATERIAL:

1 Steel

3 Stainless steel

5 Fiberglass

☒ 7 PVC

10 Asbestos-cement

2 Brass

4 Galvanized steel

6 Concrete tile

8 RMP (SR)

11 Other (specify)

12 None used (open hole)

SCREEN OR PERFORATION OPENINGS ARE:

☒ 1 Continuous slot

3 Mill slot

5 Gauzed wrapped

8 Saw cut

11 None (open hole)

2 Louvered shutter

4 Key punched

6 Wire wrapped

9 Drilled holes

7 Torch cut

10 Other (specify)

SCREEN-PERFORATED INTERVALS: From 100.3 ft. to 110.3 ft., From ft. to ft.From 93.4 ft. to 110.3 ft., From ft. to ft.GRAVEL PACK INTERVALS: From 93.4 ft. to 110.3 ft., From ft. to ft.

From ft. to ft., From ft. to ft.

6 GROUT MATERIAL:

1 Neat cement

☒ 2 Cement grout☒ 3 Bentonite

4 Other

Grout Intervals: From 0 ft. to 89.0 ft., From 89.0 ft. to 93.4 ft., From ft. to ft.

What is the nearest source of possible contamination:

1 Septic tank

4 Lateral lines

7 Pit privy

10 Livestock pens

14 Abandoned water well

2 Sewer lines

5 Cess pool

8 Sewage lagoon

11 Fuel storage

15 Oil well/Gas well

3 Watertight sewer lines

6 Seepage pit

9 Feedyard

12 Fertilizer storage

16 Other (specify below)

13 Insecticide storage

Direction from well?

How many feet?

FROM	TO	LITHOLOGIC LOG	FROM	TO	LITHOLOGIC LOG
0	7	DK BRN-BLK- top soil	98	100	Gray shale
7	10	BRN-TO BRN CLAY	100	110.3	LT GRAY S.S.
10	13.5	BRN-Plater shale			
13.5	16	GRAY Plater shale			
16	17	GRAY shly Limestone			
17	20	GRAY Plater shale			
20	30	LS.- Lt GRY, fine grained			
30	40	GRAY silty shale			
40	55	LT GRAY silty shale			
55	60	GRY shly LS			
60	70	GRY silty shale			
70	75	GRY shale & LS			
75	80	GRY silty shale			
80	93	GRY silty shale			
93	98	LT GRY S.S.			

7 CONTRACTOR'S OR LANDOWNER'S CERTIFICATION: This water well was ☒ constructed, (2) reconstructed, or (3) plugged under my jurisdiction and wascompleted on (mo/day/year) 1-23-87 and this record is true to the best of my knowledge and belief. KansasWater Well Contractor's License No. 481This Water Well Record was completed on (mo/day/yr) 2-23-87under the business name of John Mathes & Assoc.by (signature) Charles W. Poter

INSTRUCTIONS: Use typewriter or ball point pen. PLEASE PRESS FIRMLY and PRINT clearly. Please fill in blanks, underline or circle the correct answers. Send top three copies to Kansas Department of Health and Environment, Office of Oil Field and Environmental Geology, Regulation and Permitting Section, Topeka, Kansas 66620-7500, Telephone: 913-862-9360. Send one to WATER WELL OWNER and retain one for your records.