USE TYPEWRITER OR BALL POINT PEN-PRESS FIRMLY, PRINT CLEARLY.

WATER WELL RECORD
KSA 82a-1201-1215

Kansas Department of Health and Environment-Division of Environment
(Water well Contractors)
Topeka, Kansas 66620

1. Location of well:	County	Fraction	Section number	Township number	Range number
	MG	NW 1/4 NW 1/4 NW 1/4	21	T 33 S	R 16 E/W

2. Distance and direction from nearest town or city: 2½ E Independence KS 4 mi S and
Street address of well location if in city: RTD 2

3. Owner of well: Charles A Clark
R.R. or street: 2 Box 177
City, state, zip code: Independence KS 67301

4. Locate with "X" in section below:

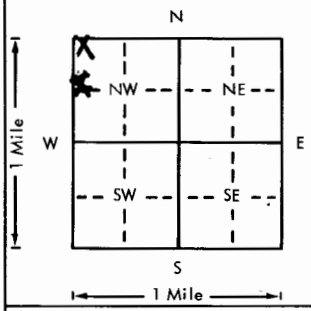

Sketch map:

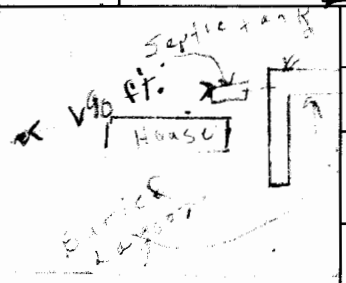

6. Bore hole dia. 8 in. Completion date 6-22-78
Well depth 103 ft.

7. X Cable tool __ Rotary __ Driven __ Dug
__ Hollow rod __ Jetted __ Bored __ Reverse rotary

8. Use: X Domestic __ Public supply __ Industry
__ Irrigation __ Air conditioning __ Stock
__ Lawn __ Oil field water __ Other

9. Casing: Material _____ Height: Above or below
Threaded ___ Welded ___ Surface 23 in.
RMP ___ PVC X Weight NA lbs./ft.
Dia. 6 in. to 50 ft. depth Wall Thickness: inches or
Dia. ___ in. to ___ ft. depth gage No. Sch. 80

10. Screen: Manufacturer's name _____
Type _____ Dia. _____
Slot/gauze _____ Length _____
Set between _____ ft. and _____ ft.
_____ ft. and _____ ft.
Gravel pack? ___ Size range of material _____

11. Static water level: 45 ft. below land surface Date 6-22-78 mo./day/yr.

12. Pumping level below land surfaces:
100 ft. after 1 hrs. pumping 3.5 g.p.m.
___ ft. after ___ hrs. pumping ___ g.p.m.
Estimated maximum yield 5.2 g.p.m.

13. Water sample submitted: mo./day/yr.
__ Yes ✓ No Date _____

14. Well head completion:
__ Pitless adapter 23 Inches above grade

15. Well grouted? yes
With: X Neat cement __ Bentonite ___ Concrete
Depth: From 0 ft. to 35 ft.

16. Nearest source of possible contamination:
ft. 110 Direction S.E Type Septic Tank
Well disinfected upon completion? X Yes ___ No

17. Pump: ___ Not installed
Manufacturer's name Jacuzzi
Model number 3J35 HP 1/2 Volts 220
Length of drop pipe 90 ft. capacity 6.0 g.p.m.
Type:
X Submersible ___ Turbine
___ Jet ___ Reciprocating
___ Centrifugal ___ Other

5. Type and color of material	From	To
Sand	0	6
Sand and red clay	6	16
Sand rock Brown	16	72
white Sand rock	72	80
Gray shale	80	94
Limestone	94	102

(Use a second sheet if needed)

18. Elevation:

Topography:
___ Hill
X Slope
___ Upland
___ Valley

19. Remarks: well floor to be poured upon site when ground firms from heavy rains.

20. Water well contractor's certification:
This well was drilled under my jurisdiction and this report is true to the best of my knowledge and belief.
Charles Clark 369
Business name License No.
Address RTD 2 Box 177 Independence KS
Signed Charles A Clark Date 6-22-78
Authorized representative

T 33 S R 16 E/W Sec 21 1/4 1/4 1/4 NW NW NW

Forward the white, blue and pink copies to the Department of Health and Environment

Form WWC-5

M1-1023