

WATER WELL PLUGGING RECORD Form WWC-5P KSA 82a-1212 ID NO.


1 **LOCATION OF WATER WELL:** Fraction SE 1/4 NW 1/4 NE 1/4 NW 1/4 Section Number 7 Township Number T 33 S Range Number 2 E W
 County: Sumner

Street/Rural Address of Well Location; if unknown, distance & direction from nearest town or intersection: If at owner's address, check here

Global Positioning Systems (GPS) information:
 Latitude: 37.20174 (in decimal degrees)
 Longitude: 097.25163 (in decimal degrees)
 Elevation: 1120
 Datum: WGS84, NAD83, NAD27
 Collection Method:

2 **WATER WELL OWNER:** Source Energy MidCon LLC
 RR#, St. Address, Box #: 1805 Shea Center Dr. #100
 City, State ZIP Code: Highlands Ranch, CO 80129

GPS unit (Make/Model: Garmin eTrex 20)
 Digital Map/Photo, Topographic Map, Land Survey
 Est. Accuracy: < 3 m, 3-5 m, 5-15 m, > 15 m

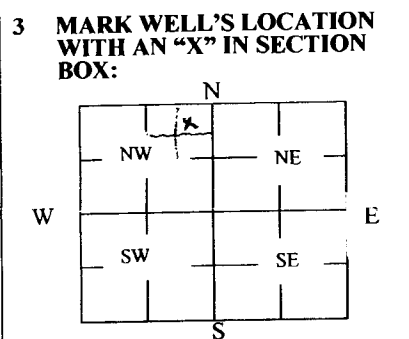

4 **DEPTH OF WELL** 200 ft.
 WELL'S STATIC WATER LEVEL 25 ft.
 WELL WAS USED AS:
 Domestic Public Water Supply Dewatering
 Irrigation Oil Field Water Supply Monitoring
 Feedlot Domestic (Lawn & Garden) Injection Well
 Industrial Air Conditioning Other _____
 Was a chemical/bacteriological sample submitted to Department? Yes No

5 **TYPE OF BLANK CASING USED:**
 Steel RMP (SR) Wrought Fiberglass Other (Specify below)
 PVC ABS Asbestos-Cement Concrete Tile
 Blank casing diameter 5 in. Was casing pulled? Yes No If yes, how much _____
 Casing height above or below land surface -60 in.

6 **GROUT PLUG MATERIAL:** Neat cement Cement grout Bentonite Other _____
 Grout Plug Intervals: From 25 ft. to 5 ft., From _____ ft. to _____ ft., From _____ to _____ ft.
 What is the nearest source of possible contamination:
 Septic tank Seepage pit Fuel Storage Other (specify below)
 Sewer lines Pit privy Fertilizer storage
 Watertight sewer lines Sewage lagoon Insecticide storage
 Lateral lines Feedyard Abandoned water well Direction from well? NW
 Cess pool Livestock pens Oil well/Gas well How many feet? 200

FROM	TO	PLUGGING MATERIALS	FROM	TO	PLUGGING MATERIALS
200	25	sand/gravel			
25	5	cement			

7 **CONTRACTOR'S OR LANDOWNER'S CERTIFICATION:** This water well was plugged under my jurisdiction and was completed on (mo/day/year) 12/29/14 and this record is true to the best of my knowledge and belief. Kansas Water Well Contractor's License No. 818. This Water Well Record was completed on (mo/day/year) 1/15/15 under the business name of Abbs Mechanical Inc. by (signature) Dianne Miller

INSTRUCTIONS: Use typewriter or ballpoint pen. Please press firmly and print clearly. Please fill in blanks, underline or circle the correct answers. Send one copy to Kansas Department of Health and Environment, Bureau of Water, Geology Section, 1000 SW Jackson St., Ste. 420, Topeka, Kansas 66612-1367. Telephone: 785/296-5524. Send one to Water Well Owner and retain one for your records. Visit us at <http://www.kdheks.gov/waterwell/index.html>.