

## WATER WELL PLUGGING RECORD Form WWC-5P

KSA 82a-1212

ID NO.


1 LOCATION OF WATER WELL: Fraction NW 1/4 SW 1/4 1/4 Section Number 8 Township Number 33 S Range Number 25 E  
 County: Cherokee

Distance and direction from nearest town or city street address of well if located within city?

 Hwy 69 + 96 North of Crest Line

2 WATER WELL OWNER: William Lyerla Global Positioning Systems (decimal degrees, min. of 4 digits)  
 RR#, St. Address, Box #: 8120 W 89th St Latitude: \_\_\_\_\_  
 City, State ZIP Code: Overland Park, KS 66209 Longitude: \_\_\_\_\_  
 Elevation: \_\_\_\_\_  
 Datum: \_\_\_\_\_  
 Collection Method: \_\_\_\_\_

3 MARK WELL'S LOCATION WITH AN "X" IN SECTION BOX:

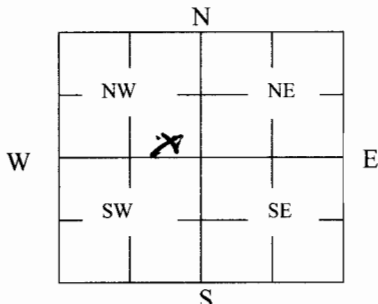

4 DEPTH OF WELL 18.5 ft.

WELL'S STATIC WATER LEVEL \_\_\_\_\_ ft.

WELL WAS USED AS:

- 1 Domestic  
 2 Irrigation  
 3 Feedlot  
 4 Industrial

- 5 Public Water Supply  
 6 Oil Field Water Supply  
 7 Domestic (Lawn & Garden)  
 8 Air Conditioning

- 9 Dewatering  
10 Monitoring  
 11 Injection Well  
 12 Other \_\_\_\_\_

Was a chemical/bacteriological sample submitted to Department? Yes \_\_\_\_\_ No X

5 TYPE OF BLANK CASING USED:

- 1 Steel 3 RMP (SR) 5 Wrought 7 Fiberglass 9 Other (Specify below)  
2 PVC 4 ABS 6 Asbestos-Cement 8 Concrete Tile

Blank casing diameter 2 in. Was casing pulled? Yes X No \_\_\_\_\_ If yes, how much 18'5

Casing height above or below land surface \_\_\_\_\_ in.

6 GROUT PLUG MATERIAL: 1 Neat cement 2 Cement grout 3 Bentonite 4 Other \_\_\_\_\_

Grout Plug Intervals: From 18.5 ft. to 1 ft., From \_\_\_\_\_ ft. to \_\_\_\_\_ ft., From \_\_\_\_\_ to \_\_\_\_\_ ft.

What is the nearest source of possible contamination:

- 1 Septic tank 6 Seepage pit 11 Fuel Storage 16 Other (specify below)  
 2 Sewer lines 7 Pit privy 12 Fertilizer storage  
 3 Watertight sewer lines 8 Sewage lagoon 13 Insecticide storage  
 4 Lateral lines 9 Feedyard 14 Abandoned water well Direction from well? \_\_\_\_\_  
 5 Cess pool 10 Livestock pens 15 Oil well/Gas well How many feet? \_\_\_\_\_

FROM	TO	PLUGGING MATERIALS	FROM	TO	PLUGGING MATERIALS
<u>18.5</u>	<u>1</u>	<u>Bentonite chip</u>			

7 CONTRACTOR'S OR LANDOWNER'S CERTIFICATION: This water well was plugged under my jurisdiction and was completed on (mo/day/year) 1-24-08 and this record is true to the best of my knowledge and belief. Kansas Water Well Contractor's License No. 704. This Water Well Record was completed on (mo/day/year) 2-23-08 under the business name of maxs by (signature) David H. H. H.

INSTRUCTIONS: Use typewriter or ballpoint pen. Please press firmly and print clearly. Please fill in blanks, underline or circle the correct answers. Send top three copies to Kansas Department of Health and Environment, Bureau of Water, Geology Section, 1000 SW Jackson St., Ste. 420, Topeka, Kansas 66612-1367. Telephone: 785/296-5522. Send one to Water Well Owner and retain one for your records. Visit us at <http://www.kdheks.gov/geo/waterwells>.