


1 LOCATION OF WATER WELL: County: Cowley Fraction: SW ~~NE~~ NW NW Section Number: 5 Township Number: T 33 S Range Number: R 3 (E/W)

Distance and direction from nearest town or city street address of well if located within city?
7 mi. West + 2 mi. S of Winfield Kansas

2 WATER WELL OWNER: Steve Hunt
 RR#, St. Address, Box #: R# 2 Box 209
 City, State, ZIP Code: Winfield, Kansas 67156 Board of Agriculture, Division of Water Resources
 Application Number: 39-884

3 LOCATE WELL'S LOCATION WITH AN "X" IN SECTION BOX: 4 DEPTH OF COMPLETED WELL: 40' ft. ELEVATION: _____

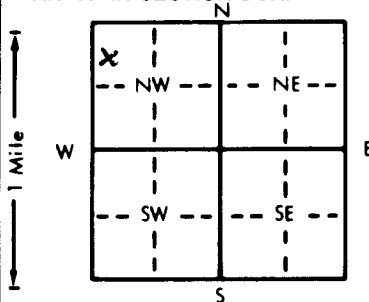

Depth(s) Groundwater Encountered 1. 8' ft. 2. _____ ft. 3. _____ ft.
 WELL'S STATIC WATER LEVEL: 8' ft. below land surface measured on mo/day/yr Mar 13, 1990
 Pump test data: Well water was 2.1' ft. after 2 hours pumping 700 gpm
 Est. Yield 1,000 gpm: Well water was 2.5' ft. after 5 hours pumping 840 gpm
 Bore Hole Diameter: 32" in. to 40" ft. and _____ in. to _____ ft.
 WELL WATER TO BE USED AS:
 5 Public water supply 8 Air conditioning 11 Injection well
 1 Domestic 3 Feedlot 6 Oil field water supply 9 Dewatering 12 Other (Specify below)
 2 Irrigation 4 Industrial 7 Lawn and garden only 10 Observation well
 Was a chemical/bacteriological sample submitted to Department? Yes _____ No X; if yes, mo/day/yr sample was submitted
 Water Well Disinfected? Yes _____ No X

5 TYPE OF BLANK CASING USED:
 1 Steel X 3 RMP (SR) 6 Asbestos-Cement 9 Other (specify below) Welded X
 2 PVC 4 ABS 7 Fiberglass _____ Threaded _____
 Blank casing diameter 1.6" in. to 28' ft., Dia _____ in. to _____ ft., Dia _____ in. to _____ ft.
 Casing height above land surface _____ in., weight _____ lbs./ft. Wall thickness or gauge No. _____

TYPE OF SCREEN OR PERFORATION MATERIAL:
 1 Steel 3 Stainless steel 5 Fiberglass 8 RMP (SR) 10 Asbestos-cement
 2 Brass 4 Galvanized steel 6 Concrete tile 9 ABS 11 Other (specify) _____
 12 None used (open hole)

SCREEN OR PERFORATION OPENINGS ARE:
 1 Continuous slot 3 Mill slot 5 Gauzed wrapped 8 Saw cut 11 None (open hole)
 2 Louvered shutter 4 Key punched 6 Wire wrapped 9 Drilled holes
 7 Torch cut 10 Other (specify) _____

SCREEN-PERFORATED INTERVALS: From 28' ft. to 40' ft., From _____ ft. to _____ ft.
 From _____ ft. to _____ ft., From _____ ft. to _____ ft.
 GRAVEL PACK INTERVALS: From 8' ft. to 40' ft., From _____ ft. to _____ ft.
 From _____ ft. to _____ ft., From _____ ft. to _____ ft.

6 GROUT MATERIAL: 1 Neat cement 2 Cement grout 3 Bentonite 4 Other _____
 Grout intervals: From 0 ft. to 8 ft., From _____ ft. to _____ ft., From _____ ft. to _____ ft.
 What is the nearest source of possible contamination:
 1 Septic tank 4 Lateral lines 7 Pit privy 10 Livestock pens 14 Abandoned water well
 2 Sewer lines 5 Cess pool 8 Sewage lagoon 11 Fuel storage 15 Oil well/Gas well
 3 Watertight sewer lines 6 Seepage pit 9 Feedyard 12 Fertilizer storage 16 Other (specify below)
 13 Insecticide storage _____
 Direction from well? _____ How many feet? Completely Isolated

FROM	TO	LITHOLOGIC LOG	FROM	TO	LITHOLOGIC LOG
1	20'	Med. + Fine Sand			
21	25	Med. + Coarse Sand			
26	30	Coarse Sand			
31	40	Very Coarse Sand			
40	42	Shale + Clay			

7 CONTRACTOR'S OR LANDOWNER'S CERTIFICATION: This water well was (1) constructed, (2) reconstructed, or (3) plugged under my jurisdiction and was completed on (mo/day/year) Pump installed May 19, 1990 and this record is true to the best of my knowledge and belief. Kansas Water Well Contractor's License No. 249 This Water Well Record was completed on (mo/day/yr) May 18, 1990 under the business name of Hunt Drilling Co. by signature Walter A Hunt

INSTRUCTIONS: Use typewriter or ball point pen, PLEASE PRESS FIRMLY and PRINT clearly. Please fill in blanks, underline or circle the correct answers. Send top three copies to Kansas Department of Health and Environment, Division of Environment, Environmental Geology Section, Topeka, KS 66620. Send one to WATER WELL OWNER and retain one for your records.

04-8403738633