USE TYPEWRITER OR BALL POINT PEN-PRESS FIRMLY, PRINT CLEARLY.

WATER WELL RECORD
KSA 82a-1201-1215

Kansas Department of Health and Environment-Division of Environment
(Water well Contractors)
Topeka, Kansas 66620

1. Location of well:	County	Fraction	Section number	Township number	Range number
WELL No 1	COWLEY	NW 1/4 NE 1/4 1/4	10	T 33 S	R 3 E/W

2. Distance and direction from nearest town or city: 4 miles west
Street address of well location if in city: 4 1/2 miles south of Winfield, Kansas

3. Owner of well: LESTER PRIEST
R.R. or ~~street~~ 3
City, state, zip code: WINFIELD, KANSAS 67156

4. Locate with "X" in section below:

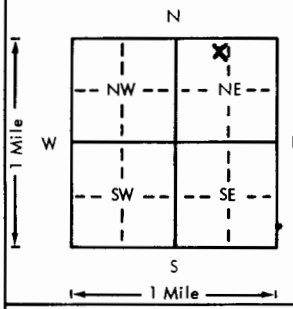

Sketch map:

6. Bore hole dia. 32" in. Completion date 6-2-79
Well depth 44 ft.

7. __ Cable tool __ Rotary __ Driven __ Dug
__ Hollow rod __ Jetted __ Bored X Reverse rotary

8. Use: __ Domestic __ Public supply __ Industry
X Irrigation __ Air conditioning __ Stock
__ Lawn __ Oil field water __ Other

9. Casing: Material STEEL Height: Above or below
Threaded ___ Welded X Surface 44" in.
RMP ___ PVC ___ Weight ___ lbs./ft.
Dia. 12 3/4 in. to 36 ft. depth Wall Thickness: inches or
Dia. ___ in. to ___ ft. depth gage No. 1219

10. Screen: Manufacturer's name DOERR METALS LARNED, KANS.
Type ARMCO INGOT IRON Dia. 12 3/4"
Slot/gage ___ Length 9'
Set between 36' ft. and 44' ft.
___ ft. and ___ ft.
Gravel pack? X Size range of material: COARSE SAND

11. Static water level: mo./day/yr.
28' ft. below land surface Date 6-2-79

12. Pumping level below land surface:
38 ft. after 6 hrs. pumping 250 g.p.m.
___ ft. after ___ hrs. pumping ___ g.p.m.
Estimated maximum yield 375 g.p.m.

13. Water sample submitted: mo./day/yr.
__ Yes X No Date ___

14. Well head completion:
__ Pitless adapter 24 Inches above grade

15. Well grouted? X
With: __ Neat cement X Bentonite __ Concrete
Depth: From 1 ft. to 10 ft.

16. Nearest source of possible contamination:
ft. 2640 Direction EAST Type SHEEP PENS
Well disinfected upon completion? __ Yes X No

17. Pump: __ Not installed
Manufacturer's name WESTERN LAND ROLLER
Model number ___ HP 20 Volts 440
Length of drop pipe 43 ft. capacity 250 g.p.m.
Type:
__ Submersible X Turbine
__ Jet __ Reciprocating
__ Centrifugal __ Other

5. Type and color of material

Type and color of material	From	To
Soil	1	27
Very fine Sand	28	30
Medium to fine Sand	31	33
Medium Sand	34	36
Medium to Coarse Sand	37	44
Shale		44

(Use a second sheet if needed)

18. Elevation:

Topography:
__ Hill
__ Slope
X Upland
__ Valley

19. Remarks:

20. Water well contractor's certification:
This well was drilled under my jurisdiction and this report is true to the best of my knowledge and belief.
Business name HUNT DRILLING Co License No. 249
Address R#2 ARKANSAS CITY, KS
Signed Walter A Hunt Date 6-8-79
Authorized representative

T 33 S R 3 E/W Sec 10 1/4 NE 1/4

Forward the white, blue and pink copies to the Department of Health and Environment

Form WWC-5

MI-1023