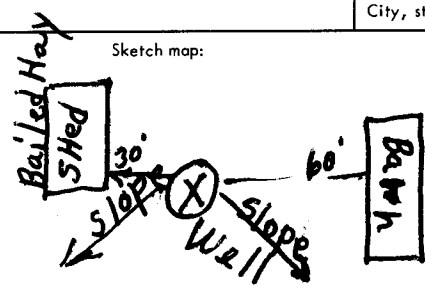


USE TYPEWRITER OR BALL POINT PEN—PRESS FIRMLY, PRINT CLEARLY.

WATER WELL RECORD
KSA 82a-1201-1215

Kansas Department of Health and Environment—Division of Environment
(Water well Contractors)
Topeka, Kansas 66620

1. Location of well:	County Cowley	Fraction SE $\frac{1}{4}$ SW $\frac{1}{4}$ SE $\frac{1}{4}$	Section number 10	Township number T 33 S	Range number R 3 E/W
2. Distance and direction from nearest town or city: 4 miles West, 4 Miles Sout. 1/2 mile West of Winfield, Ks. <small>Street address of well location if in city:</small>			3. Owner of well: Chris Finney R.R. or street: Route 3 City, state, zip code: Winfield, Kansas 67156		
4. Locate with "X" in section below: N 1 Mile W E S 1 Mile			Sketch map: 		
5. Type and color of material			6. Bore hole dia. 10 in. Completion date 11/30/77 Well depth 45 ft.		
			7. <input checked="" type="checkbox"/> Cable tool ___ Rotary ___ Driven ___ Dug ___ Hollow rod ___ Jetted ___ Bored ___ Reverse rotary		
			8. Use: <input checked="" type="checkbox"/> Domestic ___ Public supply ___ Industry ___ Irrigation ___ Air conditioning ___ Stock ___ Lawn ___ Oil field water ___ Other		
			9. Casing: Material plts Height: Above or <u>below</u> Threaded ___ Welded gl Surface 24 in. RMP ___ PVC ___ Weight ___ lbs./ft. Dia. 5 in. to 45 ft. depth Wall Thickness: inches or Dia. ___ in. to ___ ft. depth gage No. 200		
			10. Screen: Manufacturer's name Jess & Lowell Type plts Dio. 5" Slot gauze 1/16 Length 10 ft. Set between 45 ft. and 35 ft. ___ ft. and ___ ft. Gravel pack? yes Size range of material 5/8" max.		
			11. Static water level: ___ mo./day/yr. 26 ft. below land surface Date 11/30/77		
			12. Pumping level below land surface: bailer test ___ ft. after ___ hrs. pumping ___ g.p.m. ___ ft. after ___ hrs. pumping 5 g.p.m. Estimated maximum yield ___ g.p.m.		
			13. Water sample submitted: ___ mo./day/yr. Yes <input checked="" type="checkbox"/> No ___ Date ___		
			14. Well head completion: ___ Pitless adapter 24 Inches above grade		
			15. Well grouted? yes With: <input checked="" type="checkbox"/> Neat cement ___ Bentonite ___ Concrete Depth: From 0 ft. to 10 ft.		
			16. Nearest source of possible contamination: hay ft. 60 Direction east Type barn Well disinfected upon completion? <input checked="" type="checkbox"/> Yes ___ No		
			17. Pump: <input checked="" type="checkbox"/> Not installed Manufacturer's name ___ Model number ___ HP ___ Volts ___ Length of drop pipe ___ ft. capacity ___ g.p.m. Type: ___ Submersible ___ Turbine ___ Jet ___ Reciprocating ___ Centrifugal ___ Other		
			(Use a second sheet if needed)		
18. Elevation:		19. Remarks: <i>Christopher Daniel Finney</i> Concrete slab to be installed by customer at surface of ground. He knows this is a regulation.			
Topography: ___ Hill ___ Slope <input checked="" type="checkbox"/> Upland ___ Valley		20. Water well contractor's certification: This well was drilled under my jurisdiction and this report is true to the best of my knowledge and belief. Ronal Heffron Drilling #113 Business name License No. ___ Address Route 3, Winfield, Ks. 67156 Signed <i>Ronal Heffron</i> Date 12/13/77 Authorized representative			

T 33
 R 3
 E/W
 Sec 10
 1/4 SE 1/4 SW 1/4

Forward the white, blue and pink copies to the Department of Health and Environment

Form WWC-5