USE TYPEWRITER OR BALL POINT PEN-PRESS FIRMLY, PRINT CLEARLY.

T R EW sec 1/4 1/4 1/4 No.

WATER WELL RECORD
KSA 82a-1201-1215

Kansas State Dept. Of Health
(Water Well Contractors)
Forbes-Bldg. 740
Topeka, Kansas 66620

1 Location of well:	County	Township name	Fraction	Section number	Town number	Range number
WELL No 4	Cowley	Beaver	NW¼ NW¼ SW¼	11	33	3

Distance and direction from nearest town or city: 4 mi. west of 4 mi. south of Winfield, Kansas

Street address of well location if in city: R#3 Winfield Kansas

3 Owner of well: VOLLIE J. PRIEST

Address: R#3 WINFIELD, KANSAS 67156

Locate with "X" in section below:

Sketch map:

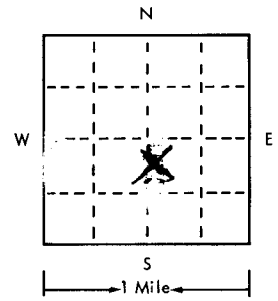

X Well depth: 41 ft. Date of completion 6-5-79
Well diameter 32" in.

5 ☐ Cable tool ☐ Rotary ☐ Driven ☐ Dug
☐ Hollow rod ☐ Jetted ☐ Bored ☒ Reverse rotary

6 Use: ☒ Domestic ☐ Public supply ☐ Industry
☒ Irrigation ☐ Air conditioning ☐ Commercial
☐ Test well ☐

7 Casing: Material STEEL Height: above/below
Threaded ☐ Welded ☒ Surface 36" in.
Diam. 12¾" Weight ___ lbs./ft.
12¾ in. to ___ ft. depth Drive shoe? ☐ Yes ☐ No
___ in. to ___ ft. depth GUAGE .219

X Screen:
Manufacturer DOERR, LARNED, KS
Type ARMCO INGOT STEEL Dia. 12¾
Slot/gauze ⅛" Length X 8'
X Set between 33 ft. and 41 ft.
Fittings:
Gravel pack ☒ Yes ☐ No Size range of material COARSE SAND

X Static water level:
22 ft. below land surface Date 6-5-79

10 Pumping level below land surfaces:
32 ft. after 10 hrs. pumping 300 g.p.m.
___ ft. after ___ hrs. pumping ___ g.p.m.
Estimated maximum yield 400 g.p.m.

11 Water sample submitted:
☐ Yes ☒ No Date ___

12 Well head completion:
☐ Pitless adapter 36 Inches above grade

13 Well grouted? ☒ Yes ☐ No
☐ Neat cement ☒ Bentonite ☐ ___
Depth: From 1 ft. to 10 ft.

14 Nearest source of possible contamination: SHEEP
2,640 Direction W Type PEN
Well disinfected upon completion? ☐ Yes ☒ No

15 Pump: ☐ Not installed
Manufacturer's name WESTERN LAND ROLLER
Model number ___ HP 20 Volts 440
Length of drop pipe 40 ft. capacity 300 g.m.p.
Type:
☐ Submersible ☒ Turbine
☐ Jet ☐ Reciprocating
☐ Certrifugal ☐ Other

2 Type and color of material	From	To
Soil + clay	1	19
Fine Sand	20	22
Medium Sand with some clay	23	26
Fine sand and a little clay	27	30
Coarse clean sand.	31	41
Shale		41

(use a second sheet if needed)

16 Remarks: elevation

Topography:
☐ Hill
☐ Slope
☒ Upland
☐ Valley

17 Water well contractor's certification:
This well was drilled under my jurisdiction and this report is true to the best of my knowledge and belief.
HUNT DRILLING Co 249
Business name License No.
Address R#2 ARKANSAS CITY KS
Signed Walter A. Hunt Date 6-9-79
Authorized representative

33 3W 11 NWNW SW

Forward the white, blue and pink copies to the Kansas State Dept. Of Health.

Form WWC-5

677-H