USE TYPEWRITER OR BALL POINT PEN-PRESS FIRMLY, PRINT CLEARLY.

WATER WELL RECORD
KSA 82a-1201-1215

Kansas Department of Health and Environment-Division of Environment
(Water well Contractors)
Topeka, Kansas 66620

1. Location of well:	County	Fraction	Section number	Township number	Range number
	COWLEY	SW 1/4 SE 1/4 1/4	11	T 33 S	R 3 E/W

2. Distance and direction from nearest town or city: WINFIELD, KS
Street address of well location if in city: 5 1/4 Mi W 3 " #5

3. Owner of well: VOLLIE PRIEST
R.R. ~~or street~~: #3
City, state, zip code: WINFIELD, KANSAS 67156

4. Locate with "X" in section below:

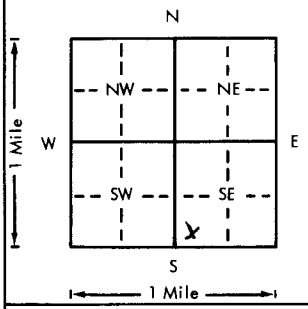

Sketch map:

6. Bore hole dia. 32 in. Completion date 5-6-77
Well depth 47 ft.

7. __ Cable tool __ Rotary __ Driven __ Dug
__ Hollow rod __ Jetted __ Bored X Reverse rotary

8. Use: __ Domestic __ Public supply __ Industry
X Irrigation __ Air conditioning __ Stock
__ Lawn __ Oil field water __ Other

9. Casing: Material STEEL Height: Above or below
Threaded ___ Welded X Surface 24" in.
RMP ___ PVC ___ Weight ___ lbs./ft.
Dia. 12 in. to 35 ft. depth Wall Thickness: inches or
Dia. ___ in. to ___ ft. depth gage No. 1219

5. Type and color of material	From	To
1'-23' Soil		
24'-31' Fine to Medium Sand		
32'-47' Medium to Coarse Sand		
47' Shale		

(Use a second sheet if needed)

10. Screen: Manufacturer's name DOERR
Type 101 MILD STEEL Dia. 12"
Slot/gauze 1/8" Length 12'
Set between 35' ft. and 47' ft.
___ ft. and ___ ft.
Gravel pack? X Size range of material COARSE SAND

11. Static water level: mo./day/yr.
22 ft. below land surface Date 5-7-77

12. Pumping level below land surfaces:
33 ft. after 4 hrs. pumping 300 g.p.m.
___ ft. after ___ hrs. pumping ___ g.p.m.
Estimated maximum yield 450 g.p.m.

13. Water sample submitted: mo./day/yr.
__ Yes X No Date ___

14. Well head completion:
__ Pitless adapter 24" Inches above grade

15. Well grouted? ~~NO~~ Yes
With: __ Neat cement X Bentonite __ Concrete
Depth: From 0 ft. to 25 ft. MNC

16. Nearest source of possible contamination:
ft. ___ Direction ___ Type ___
Well disinfected upon completion? ___ Yes ___ No

17. Pump: __ Not installed
Manufacturer's name WESTERN LAND ROLLER
Model number ___ HP 10 Volts DIESEL
Length of drop pipe 46 ft. capacity 300 g.p.m.
Type:
__ Submersible X Turbine
__ Jet __ Reciprocating
__ Centrifugal __ Other

18. Elevation:
Topography:
__ Hill
__ Slope
__ Upland
__ Valley

19. Remarks: Well to be used for irrigation only.

20. Water well contractor's certification:
This well was drilled under my jurisdiction and this report is true to the best of my knowledge and belief.
HUNT DRILLING Co 249
Business name License No.
Address ARKANSAS CITY, KS 67005
Signed Walter A Hunt Date 6-10
Authorized representative

T 33 S R 3 E/W (E) Sec 11 1/4 SW 1/4 SE 1/4

Forward the white, blue and pink copies to the Department of Health and Environment

Form WWC-5

MI-1023