USE TYPEWRITER OR BALL POINT PEN-PRESS FIRMLY, PRINT CLEARLY.

WATER WELL RECORD
KSA 82a-1201-1215

Kansas Department of Health and Environment-Division of Environment
(Water well Contractors)
Topeka, Kansas 66620

1. Location of well:	County	Fraction	Section number	Township number	Range number
WELL No 3	COWLEY	NW 1/4 NE 1/4 1/4	11	T 33 S	R 3 E/W

2. Distance and direction from nearest town or city: 4 miles west
Street address of well location if in city: 4 1/2 miles south of Winfield, Ks

3. Owner of well: LESTER PRIEST
R.R. or street: 3
City, state, zip code: WINFIELD, KANSAS 67156

4. Locate with "X" in section below:

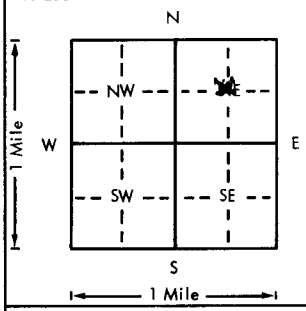

Sketch map:

6. Bore hole dia. 32 in. Completion date 6-2-79
Well depth 42 ft.

7. __ Cable tool __ Rotary __ Driven __ Dug
__ Hollow rod __ Jetted __ Bored X Reverse rotary

8. Use: __ Domestic __ Public supply __ Industry
X Irrigation __ Air conditioning __ Stock
__ Lawn __ Oil field water __ Other

9. Casing: Material STEEL Height: Above or below
Threaded ___ Welded X Surface 48" in.
RMP ___ PVC ___ Weight ___ lbs./ft.
Dia. 12 3/4" in. to 34' ft. depth Wall Thickness: inches or
Dia. ___ in. to ___ ft. depth gage No. 1 219

10. Screen: Manufacturer's name DOERR METALS LARNED KANS.
Type ARNCO INGOT IRON Dia. 12 3/4"
Slot/~~gauge~~ ___ Length 8'
Set between 36' ft. and 42' ft.
___ ft. and ___ ft.
Gravel pack? X Size range of material COARSE SAND

11. Static water level: mo./day/yr.
28' 8" ft. below land surface Date 6-2-79

12. Pumping level below land surfaces:
36 ft. after 6 hrs. pumping 140 g.p.m.
___ ft. after ___ hrs. pumping ___ g.p.m.
Estimated maximum yield 200 g.p.m.

13. Water sample submitted: mo./day/yr.
___ Yes X No Date ___

14. Well head completion:
___ Pitless adapter 48 Inches above grade

15. Well grouted? X
With: ___ Neat cement X Bentonite ___ Concrete
Depth: From 1 ft. to 10 ft.

16. Nearest source of possible contamination:
ft. 2640 Direction EAST Type SHEEP PENS
Well disinfected upon completion? ___ Yes X No

17. Pump: ___ Not installed
Manufacturer's name WESTERN LAND ROLLER Co.
Model number ___ HP 15 Volts 440
Length of drop pipe 41 ft. capacity 140 g.p.m.
Type:
___ Submersible X Turbine
___ Jet ___ Reciprocating
___ Centrifugal ___ Other

5. Type and color of materiol	From	To
Soil + clay	1	27
Very fine Sand	28	33
Medium to Fine Sand	34	38
Medium to Coarse Sand	38	42
Shale		42

(Use a second sheet if needed)

18. Elevation:

Topography:
___ Hill
___ Slope
X Upland
___ Valley

19. Remarks:

20. Water well contractor's certification:
This well was drilled under my jurisdiction and this report is true to the best of my knowledge and belief.
HUNT DRILLING Co 249
Business name License No.
Address RR 2 ARKANSAS CITY, KS
Signed Walter A Hunt Date 6-8-79
Authorized representative

T 33 S R 3 E/W Sec 11 1/4 1/4 1/4 1/4 NW NE

Forward the white, blue and pink copies to the Department of Health and Environment

Form WWC-5

M1-1023