USE TYPEWRITER OR BALL POINT PEN-PRESS FIRMLY, PRINT CLEARLY.

WATER WELL RECORD
KSA 82a-1201-1215

Kansas Department of Health and Environment-Division of Environment
(Water well Contractors)
Topeka, Kansas 66620

1. Location of well:	County	Fraction	Section number	Township number	Range number
	Cowley	SE NE ~~NE~~ 1/4 ~~NE~~ 1/4 NE 1/4	14	T 33 S	R 3 E

2. Distance and direction from nearest town or city: WINFIELD, KS
Street address of well location if in city: 4 mi. S 3½ mi. W

3. Owner of well: STANLEY ABEL
R.R. ~~or street~~ # 2
City, state, zip code: WINFIELD, KS 67156

4. Locate with "X" in section below: + 45

Sketch map:

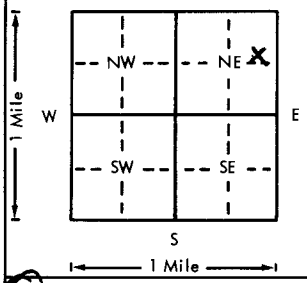

6. Bore hole dia. 4" in. Completion date 5-26-77
Well depth 47 ft.

7. __ Cable tool X Rotary __ Driven __ Dug
__ Hollow rod __ Jetted __ Bored X Reverse rotary

8. Use: __ Domestic __ Public supply __ Industry
__ Irrigation __ Air conditioning X Stock
__ Lawn __ Oil field water __ Other

9. Casing: Material PVC
Threaded ___ Welded X
RMP ___ PVC X
Dia. 4" in. to 37' ft. depth
Dia. [redacted] ft. depth
Height: Above or below Surface 12" in.
Weight 1.47 lbs./ft.
Wall Thickness: inches or gage No.

10. Screen: Manufacturer's name Hand perforated PVC Casing
Type plastic Dia. 4" MHC
Slot/gauze ___ Length 10'
Set between 37' ft. and 47' ft.
___ ft. and ___ ft.
Gravel pack? X Size range of material: COARSE SAND

11. Static water level: mo./day/yr.
25 ft. below land surface Date 5-27-77

12. Pumping level below land surfaces:
___ ft. after ___ hrs. pumping ___ g.p.m.
___ ft. after ___ hrs. pumping ___ g.p.m.
Estimated maximum yield ___ g.p.m.

13. Water sample submitted: mo./day/yr.
__ Yes X No Date

14. Well head completion:
__ Pitless adapter 12" Inches above grade

15. Well grouted? ~~NA~~ yes
With: __ Neat cement __ Bentonite X Concrete
Depth: From 0 ft. to 10 ft. MHC

16. Nearest source of possible contamination:
ft. ___ Direction ___ Type None
Well disinfected upon completion? ___ Yes X No

17. Pump: X Not installed
Manufacturer's name
Model number ___ HP ___ Volts ___
Length of drop pipe ___ ft. capacity ___ g.p.m.
Type:
__ Submersible __ Turbine
X Jet __ Reciprocating
__ Centrifugal __ Other

5. Type and color of material	From	To
Soil	1'	25'
Fine Sand	26	36'
Medium to Fine Sand	37'	42'
Medium Sand	43'	47'
Shale	47'	

Well is located at edge of pasture to pump water to cattle only. The presence of the cattle is the only possible pollution to their own water supply

(Use a second sheet if needed)

18. Elevation:

Topography:
__ Hill
__ Slope
X Upland
__ Valley

19. Remarks: Owner will put his own jet pump in to water 20 cows.

20. Water well contractor's certification:
This well was drilled under my jurisdiction and this report is true to the best of my knowledge and belief.
Business name HUNT DRILLING Co 249 License No.
Address ARKANSAS CITY KS 67005
Signed Walter A Hunt Date 6-15-77
Authorized representative

T 33 R 3 (E) W Sec 14 1/4 SE NE 1/4 1/4 1/4

Forward the white, blue and pink copies to the Department of Health and Environment

Form WWC-5

MI-1023