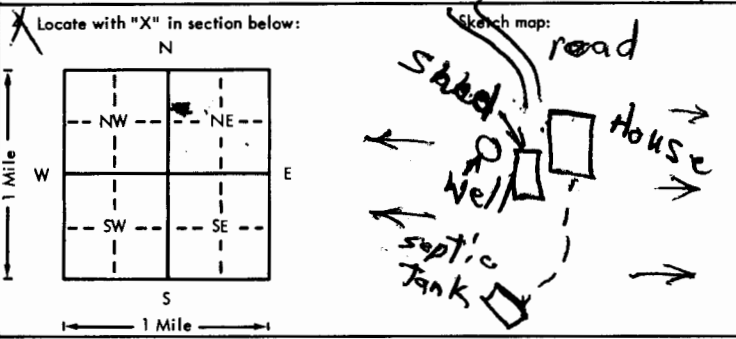


USE TYPEWRITER OR BALL POINT PEN-PRESS FIRMLY, PRINT CLEARLY.

WATER WELL RECORD
KSA 82a-1201-1215

Kansas Department of Health and Environment-Division of Environment (Water well Contractors) Topeka, Kansas 66620

1. Location of well: County Cowley		Section number 17		Township number T 33 S R 2E E/W		Range number 2E	
2. Distance and direction from nearest town or city: 7 miles SW of Winfield		3. Owner of well: Irvin A. McClung R.R. or street: R.R. 2 City, state, zip code: Winfield, KANSAS 67156					
4. Locate with "X" in section below: 		6. Bore hole dia. 10 in. Completion date 8-14-77 Well depth 43 ft.		7. <input checked="" type="checkbox"/> Cable tool <input checked="" type="checkbox"/> Rotary <input type="checkbox"/> Driven <input type="checkbox"/> Dug <input type="checkbox"/> Hollow rod <input type="checkbox"/> Jetted <input type="checkbox"/> Bored <input type="checkbox"/> Reverse rotary		8. Use: <input checked="" type="checkbox"/> Domestic <input type="checkbox"/> Public supply <input type="checkbox"/> Industry <input type="checkbox"/> Irrigation <input type="checkbox"/> Air conditioning <input type="checkbox"/> Stock <input type="checkbox"/> Lawn <input type="checkbox"/> Oil field water <input type="checkbox"/> Other	
5. Type and color of material		From		To		9. Casing: Material RMP Height: Above or below Threaded <input type="checkbox"/> Welded <input type="checkbox"/> Surface 24 in. RMP <input type="checkbox"/> PVC <input type="checkbox"/> Weight 195 lbs./ft. 100 Dia 6 in. to 43 ft. depth Wall Thickness: inches or Dia. <input type="checkbox"/> in. to <input type="checkbox"/> ft. depth gage No. 200	
Top Soil & SAND		0' 5'		5' 25'		10. Screen: Manufacturer's name Sunflower Type RMP Dia. 6" Slot/gauze 1/16" Length 20' Set between 23 ft. and 43 ft. <input type="checkbox"/> ft. and <input type="checkbox"/> ft.	
Fine SAND		5' 25'		25' 43'		Gravel pack? YES Size range of material 1/4" SAND	
Medium SAND		25' 43'				11. Static water level: NA mo./day/yr. ft. below land surface Date	
						12. Pumping level below land surfaces: NA ft. after hrs. pumping g.p.m. ft. after hrs. pumping g.p.m. Estimated maximum yield g.p.m.	
						13. Water sample submitted: mo./day/yr. Yes <input checked="" type="checkbox"/> No <input type="checkbox"/> Date	
						14. Well head completion: NO Pitless adapter _____ Inches above grade	
						15. Well grouted? NO With: Neat cement <input type="checkbox"/> Bentonite <input type="checkbox"/> Concrete <input type="checkbox"/> Depth: From _____ ft. to _____ ft.	
						16. Nearest source of possible contamination: ft. 60 Direction South Type SEPTIC TANK Well disinfected upon completion? Yes <input type="checkbox"/> No <input checked="" type="checkbox"/>	
						17. Pump: <input checked="" type="checkbox"/> Not installed Manufacturer's name _____ Model number _____ HP _____ Volts _____ Length of drop pipe _____ ft. capacity _____ g.p.m. Type: <input type="checkbox"/> Submersible <input type="checkbox"/> Turbine <input type="checkbox"/> Jet <input type="checkbox"/> Reciprocating <input type="checkbox"/> Centrifugal <input type="checkbox"/> Other	
18. Elevation:		19. Remarks:		20. Water well contractor's certification:			
Topography: <input type="checkbox"/> Hill <input checked="" type="checkbox"/> Slope <input checked="" type="checkbox"/> Upland <input type="checkbox"/> Valley		I drilled & cased this well. I explained all regulations to landowner. He is to complete it.		This well was drilled under my jurisdiction and this report is true to the best of my knowledge and belief. EASTMAN Drilling 299 Business name _____ License No. _____ Address Box 115, Winfield Signed Ed Eastman Date 8-23-77 Authorized representative			

T 33 S R 2E E/W
 Sec 17 SW NE NE

Forward the white, blue and pink copies to the Department of Health and Environment

Form WWC-5