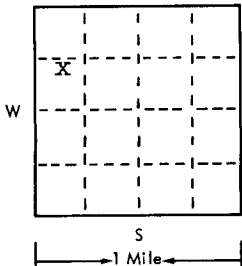
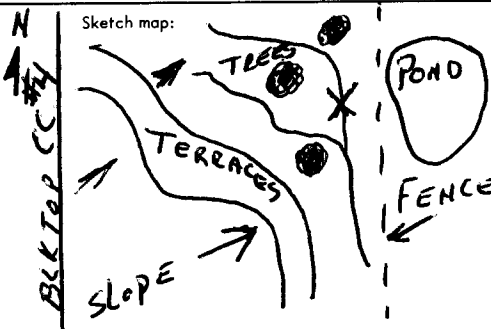


USE TYPEWRITER OR BALL  
POINT PEN-PRESS FIRMLY,  
PRINT CLEARLY.

WATER WELL RECORD  
KSA 82a-1201-1215

T R EW sec 1/4 1/4 1/4 No.

Kansas State Dept. Of Health  
(Water Well Contractors)  
Forbes-Bldg. 740  
Topeka, Kansas 66620

1 Location of well:	County <b>Cowley</b>	Township name <b>Beaver</b>	Fraction <b>NE SW NW</b>	Section number <b>17</b>	Town number <b>33</b>	Range number <b>3E</b>
Distance and direction from nearest town or city: <b>6 S 2 E Oxford</b> Street address of well location if in city:			3 Owner of well: <b>Bill Carson Jr.</b> Address: <b>box 402 Oxford, Kansas</b>			
Locate with "X" in section below: 			Sketch map: 			4 Well depth: <b>85</b> ft. Date of completion <b>6/7/79</b> Well diameter <b>10 1/4</b> in.
2 Type and color of material			From To			5 <input checked="" type="checkbox"/> Cable tool <input type="checkbox"/> Rotary <input type="checkbox"/> Driven <input type="checkbox"/> Dug <input type="checkbox"/> Hollow rod <input type="checkbox"/> Jetted <input type="checkbox"/> Bored <input type="checkbox"/> Reverse rotary
						6 Use: <input checked="" type="checkbox"/> Domestic <input type="checkbox"/> Public supply <input type="checkbox"/> Industry <input type="checkbox"/> Irrigation <input type="checkbox"/> Air conditioning <input type="checkbox"/> Commercial <input type="checkbox"/> Test well <input type="checkbox"/>
Top Soil Red Clay Sandy Red Clay Silty Sand Fine to Med. Grained Soft Light Green Shale Some thin Lime Shells Med Soft Blue Shale W/ Lime Shells (Small Water @ 60' Approx. 375 G.P.M.) Blue Shale Soft To Med. Shale Tan to Buff Shale Conglomerate Blue Green Red some White Lime Shells ( Good Water zone Approx. 30/50g.p.m.)			7 Casing: Material <b>PVC</b> Height: <b>above</b> below Threaded <input type="checkbox"/> Welded <input type="checkbox"/> Surface <b>38</b> in. Diam. <b>SCHED 40</b> Weight <b>5 1/2</b> lbs./ft. <b>5 1/2</b> in. to <b>T.D.</b> ft. depth Drive shoe? <input type="checkbox"/> Yes <input type="checkbox"/> No <b>5 1/2</b> in. to <b>85</b> ft. depth			8 Screen: Manufacturer <b>PUMPOO</b> Type <b>PVC SCD 40</b> Dia. <b>5"</b> Slot/gauze <b>.020</b> Length <b>10'</b> Set between <b>75</b> ft. and <b>85</b> ft. Fittings: Gravel pack <input checked="" type="checkbox"/> Yes <input type="checkbox"/> No Size range of material <b>1/2 x 5/8</b>
						9 Static water level: <b>60</b> ft. below land surface Date <b>6/6/79</b>
(use a second sheet if needed)			10 Pumping level below land surfaces: <b>NONE</b> ft. after <b>NONE</b> hrs. pumping <b>---</b> g.p.m. <b>---</b> ft. after <b>---</b> hrs. pumping <b>---</b> g.p.m. Estimated maximum yield <b>---</b> g.p.m.			11 Water sample submitted: <input type="checkbox"/> Yes <input checked="" type="checkbox"/> No Date <b>---</b>
						12 Well head completion: <input type="checkbox"/> Pitless adapter <input type="checkbox"/> Inches above grade
16 Remarks: elevation Owner plans to erect windmill over well and install pitless adapter, at which time he will pour concrete slab, he has been informed of this regulation. Topography: <input checked="" type="checkbox"/> Hill <input type="checkbox"/> Slope <input type="checkbox"/> Upland <input type="checkbox"/> Valley			13 Well grouted? <input checked="" type="checkbox"/> Yes <input type="checkbox"/> No <input checked="" type="checkbox"/> Neat cement <input type="checkbox"/> Bentonite <input type="checkbox"/> Depth: From <b>3</b> ft. to <b>18</b> ft.			14 Nearest source of possible contamination: ft. <b>1200</b> Direction <b>west</b> Type <b>septic</b> Well disinfected upon completion? <input checked="" type="checkbox"/> Yes <input type="checkbox"/> No
						15 Pump: <input checked="" type="checkbox"/> Not installed Manufacturer's name <b>---</b> Model number <b>---</b> HP <b>---</b> Volts <b>---</b> Length of drop pipe <b>---</b> ft. capacity <b>---</b> g.m.p. Type: <input type="checkbox"/> Submersible <input type="checkbox"/> Turbine <input type="checkbox"/> Jet <input type="checkbox"/> Reciprocating <input type="checkbox"/> Centrifugal <input type="checkbox"/> Other
17 Water well contractor's certification: This well was drilled under my jurisdiction and this report is true to the best of my knowledge and belief. <b>G &amp; S Drilling</b> 171 Business name <b>708 East 10th Winfield, Ks</b> License No. Address <b>---</b> Signed <b>---</b> Date <b>6/15/79</b> Authorized representative						

Forward the white, blue and pink copies to the Kansas State Dept. Of Health.

Form WWC-5