USE TYPEWRITER OR BALL POINT PEN-PRESS FIRMLY, PRINT CLEARLY.

T R EW sec 1/4 1/4 1/4 No.

WATER WELL RECORD
KSA 82a-1201-1215

Kansas State Dept. Of Health
(Water Well Contractors)
Forbes-Bldg. 740
Topeka, Kansas 66620

1 Location of well:	County	Township name	Fraction	Section number	Town number	Range number
	Cowley	Beaver	NE of NE	21	33	3E

Distance and direction from nearest town or city: 10 Miles SW from Winfield Ks

Street address of well location if in city:

3 Owner of well: Carroll Wiseley

Address: R#2 Winfield Kansas 67156

Locate with "X" in section below: Sketch map:

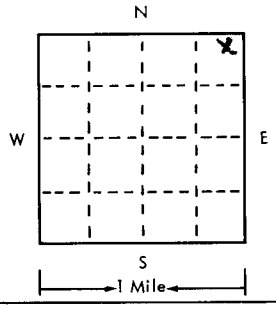

2 Type and color of material	From	To
Clay	1'	29'
Clay & Sand	29'	35'
Medium & Coarse Sand	35	41
(use a second sheet if needed)		

4 Well depth: 41' ft. Date of completion 8-8-75
Well diameter 32 in.

5 ☐ Cable tool ☐ Rotary ☐ Driven ☐ Dug
☐ Hollow rod ☐ Jetted ☐ Bored ☒ Reverse rotary

6 Use: ☒ Domestic ☐ Public supply ☐ Industry
☐ Irrigation ☐ Air conditioning ☐ Commercial
☐ Test well ☐

7 Casing: Material PVC Height: above/below
Threaded ☐ Welded ☐ Surface 12 in.
Diam. Weight 6679 lbs./ft. per 100'
8 in. to 41 ft. depth Drive shoe? ☐ Yes ☐ No
in. to ft. depth Thickness - .410

8 Screen:
Manufacturer Hand slotted PVC
Type Dia.
Slot/~~gauze~~ 1/16" Length 6'
Set between 35 ft. and 41 ft.
Fittings:
Gravel pack ☒ Yes ☐ No Size range of material Medium to Coarse Sand

9 Static water level:
35' ft. below land surface Date 8-8-75

10 Pumping level below land surfaces:
39 ft. after 10 hrs. pumping 10 g.p.m.
ft. after hrs. pumping g.p.m.
Estimated maximum yield 12 g.p.m.

11 Water sample submitted:
☐ Yes ☒ No Date

12 Well head completion:
☐ Pitless adapter ☒ Inches above grade

13 Well grouted? ☒ Yes ☐ No
☐ Neat cement ☐ Bentonite ☐ Rich Cement
Depth: From 0 ft. to 10 ft.

14 Nearest source of possible contamination:
ft. 600 Direction West Type Feed Lot
Well disinfected upon completion? ☒ Yes ☐ No

15 Pump: ☒ Not installed
Manufacturer's name F & W
Model number HP 1/2 Volts 220
Length of drop pipe 40 ft. capacity 10 g.m.p.
Type:
☒ Submersible ☐ Turbine
☐ Jet ☐ Reciprocating
☐ Certrifugal ☐ Other

16 Remarks: elevation
Owner installed pump and well curb & well house.

Topography:
☐ Hill
☐ Slope
☒ Upland
☐ Valley

17 Water well contractor's certification:
This well was drilled under my jurisdiction and this report is true to the best of my knowledge and belief.
Hunt Drilling Co 249
Business name License No.
Address R#2 Arkansas City Ks
Signed Walter A. Hunt Date 8-19-75
Authorized representative

Forward the white, blue and pink copies to the Kansas State Dept. Of Health.

Form WWC-5

677-H