


1 LOCATION OF WATER WELL: County: Cowley Fraction: SE 1/4 NE 1/4 SE 1/4 Section Number: 25 Township Number: T 33 S Range Number: R 3 E/W

Distance and direction from nearest town or city street address of well if located within city?
4 1/2 miles N. of Arkansas City

2 WATER WELL OWNER: Emile Fildes
 RR#, St. Address, Box #: R#2 Arkansas City, Kansas 67005
 City, State, ZIP Code: Arkansas City, Kansas 67005
 Board of Agriculture, Division of Water Resources
 Application Number:

3 LOCATE WELL'S LOCATION WITH AN "X" IN SECTION BOX:

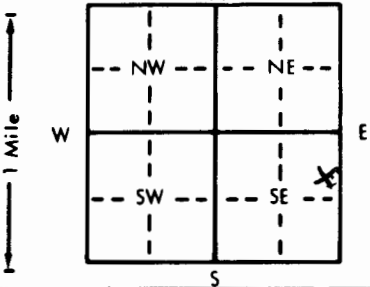

4 DEPTH OF COMPLETED WELL: 43' ft. ELEVATION:
 Depth(s) Groundwater Encountered 1. 24' ft. 2. ft. 3. ft.
 WELL'S STATIC WATER LEVEL: 24' ft. below land surface measured on mo/day/yr
 Pump test data: Well water was ft. after hours pumping gpm
 Est. Yield gpm: Well water was ft. after hours pumping gpm
 Bore Hole Diameter: 8" in. to 43' ft., and in. to ft.
 WELL WATER TO BE USED AS:
 1 Domestic 3 Feedlot 6 Oil field water supply 9 Dewatering 12 Other (Specify below)
 2 Irrigation 4 Industrial 7 Lawn and garden only 10 Observation well
 Was a chemical/bacteriological sample submitted to Department? Yes.....No.......... If yes, mo/day/yr sample was submitted
 Water Well Disinfected? Yes No

5 TYPE OF BLANK CASING USED:
 1 Steel 3 RMP (SR) 5 Wrought iron 8 Concrete tile CASING JOINTS: Glued Clamped
 2 PVC 4 ABS 6 Asbestos-Cement 9 Other (specify below) Welded
 7 Fiberglass Threaded
 Blank casing diameter: 4" in. to 38' ft., Dia. in. to ft., Dia. in. to ft.
 Casing height above land surface: 18 in., weight 200# PVC SDR21 lbs./ft. Wall thickness or gauge No.

TYPE OF SCREEN OR PERFORATION MATERIAL:
 1 Steel 3 Stainless steel 5 Fiberglass 7 PVC 10 Asbestos-cement
 2 Brass 4 Galvanized steel 6 Concrete tile 8 RMP (SR) 11 Other (specify) RUTH-BERRY
 12 None used (open hole) SAND-PAK
 SCREEN OR PERFORATION OPENINGS ARE:
 1 Continuous slot 3 Mill slot 5 Gauzed wrapped 8 Saw cut 11 None (open hole)
 2 Louvered shutter 4 Key punched 6 Wire wrapped 9 Drilled holes
 7 Torch cut 10 Other (specify)

SCREEN-PERFORATED INTERVALS: From 38' ft. to 49' ft., From ft. to ft.
 From ft. to ft., From ft. to ft.
 GRAVEL PACK INTERVALS: From 20' ft. to 43' ft., From ft. to ft.
 From ft. to ft., From ft. to ft.

6 GROUT MATERIAL: 1 Neat cement 2 Cement grout 3 Bentonite 4 Other BENTONITE + CLAY
 Grout Intervals: From 1' ft. to 10' ft., From ft. to ft., From ft. to ft.
 What is the nearest source of possible contamination:
 1 Septic tank 4 Lateral lines 7 Pit privy 10 Livestock pens 14 Abandoned water well
 2 Sewer lines 150' 5 Cess pool 8 Sewage lagoon 11 Fuel storage 15 Oil well/Gas well
 3 Watertight sewer lines 6 Seepage pit 9 Feedyard 12 Fertilizer storage 16 Other (specify below)
 13 Insecticide storage
 Direction from well? West How many feet? 100'

FROM	TO	LITHOLOGIC LOG	FROM	TO	LITHOLOGIC LOG
1	22	SOIL + CLAY			
23	37	VERY FINE SAND			
38	43	FINE TO MEDIUM SAND			
	43'	HARD SHALE			

7 CONTRACTOR'S OR LANDOWNER'S CERTIFICATION: This water well was (1) constructed, (2) reconstructed, or (3) plugged under my jurisdiction and was completed on (mo/day/year) MAY 26, 1983 and this record is true to the best of my knowledge and belief. Kansas Water Well Contractor's License No. 249 This Water Well Record was completed on (mo/day/yr) June 23, 1983 under the business name of HUNT DRILL INC Co by (signature) Walter A Hunt

INSTRUCTIONS: Use typewriter or ball point pen, PLEASE PRESS FIRMLY and PRINT clearly. Please fill in blanks, underline or circle the correct answers. Send top three copies to Kansas Department of Health and Environment, Division of Environment, Environmental Geology Section, Topeka, KS 66620. Send one to WATER WELL OWNER and retain one for your records.

OFFICE USE ONLY
 T
 3
 3
 R
 3
 3
 SEC.
 85
 SE 1/4
 NE 1/4
 SE 1/4