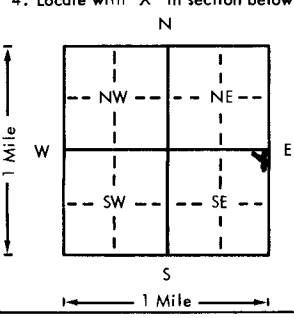


USE TYPEWRITER OR BALL
POINT PEN-PRESS FIRMLY,
PRINT CLEARLY.

WATER WELL RECORD
KSA 82a-1201-1215

Kansas Department of Health and
Environment-Division of Environment
(Water well Contractors)
Topeka, Kansas 66620

1. Location of well:		County Cowley	Fraction NE 1/4 NE 1/4 SE 1/4	Section number 33	Township number T 33 S	Range number R 4 E
2. Distance and direction from nearest town or city: 6 mi. south of Winfield on County 27, 1/2 Mi east, 1/2 mi South			3. Owner of well: Walter Crane R.R. or street: Route 3 City, state, zip code: Winfield, Kansas			
4. Locate with "X" in section below: 			6. Bore hole dia. 10 in. Completion date 10/1/79 Well depth 90 ft.			
5. Type and color of material			7. <input checked="" type="checkbox"/> Cable tool <input type="checkbox"/> Rotary <input type="checkbox"/> Driven <input type="checkbox"/> Dug <input type="checkbox"/> Hollow rod <input type="checkbox"/> Jetted <input type="checkbox"/> Bored <input type="checkbox"/> Reverse rotary			
			8. Use: <input checked="" type="checkbox"/> Domestic <input type="checkbox"/> Public supply <input type="checkbox"/> Industry <input type="checkbox"/> Irrigation <input type="checkbox"/> Air conditioning <input type="checkbox"/> Stock <input type="checkbox"/> Lawn <input type="checkbox"/> Oil field water <input type="checkbox"/> Other			
			9. Casing: Material PTB Height Above or below Threaded <input type="checkbox"/> Welded <input type="checkbox"/> Surface 24 in. RMP <input type="checkbox"/> PVC <input checked="" type="checkbox"/> Weight <input type="checkbox"/> lbs./ft. Dia. 5 in. to 90 ft. depth Wall Thickness: inches or Dia. <input type="checkbox"/> in. to <input type="checkbox"/> ft. depth Page No. #200			
			10. Screen: Manufacturer's name unknown Casing perforated - Bottom 10 ft. Type <input type="checkbox"/> Dia 5" Slot/gauze 1/16" Length 10 FT Set between 80 ft. and 90 ft. ft. and <input type="checkbox"/> ft. Gravel pack? yes Size range of material 1/2			
			11. Static water level: <input type="checkbox"/> mo./day/yr. 75 ft. below land surface Date 10/1/79			
			12. Pumping level below land surfaces: bailer test <input type="checkbox"/> ft. after <input type="checkbox"/> hrs. pumping <input type="checkbox"/> g.p.m. <input type="checkbox"/> ft. after <input type="checkbox"/> hrs. pumping <input type="checkbox"/> g.p.m. Estimated maximum yield 15 g.p.m.			
			13. Water sample submitted: <input type="checkbox"/> mo./day/yr. <input type="checkbox"/> Yes <input checked="" type="checkbox"/> No Date <input type="checkbox"/>			
			14. Well head completion: <input type="checkbox"/> Pitless adapter 24 inches above grade			
			15. Well grouted? yes With: <input checked="" type="checkbox"/> Neat cement <input type="checkbox"/> Bentonite <input type="checkbox"/> Concrete Depth: From 0 ft. to 10 ft.			
			16. Nearest source of possible contamination: Septic tank ft. 150 Direction NE Type to be install Well disinfected upon completion? <input checked="" type="checkbox"/> Yes <input type="checkbox"/> No			
18. Elevation: unknown Topography: <input type="checkbox"/> Hill <input checked="" type="checkbox"/> Slope <input type="checkbox"/> Upland <input type="checkbox"/> Valley			19. Remarks: Concrete slab slab to be installed by customer at surface of ground. He knows this is a regulation. Walter A. Crane			
			20. Water well contractor's certification: This well was drilled under my jurisdiction and this report is true to the best of my knowledge and belief. Ronal Heffron Drilling #113 Business name Route 3, Box 90, Winfield, KS Address Ronal Heffron Signed Ronal Heffron Date 10-28-79 Authorized representative			

Forward the white, blue and pink copies to the Department of Health and Environment

Form WWC-5