


| | | | | | | | |
|---------------------------|-----------------------------|-----------|--------|-----------|--------|----------|-----------|
| 1 LOCATION OF WATER WELL: | Fraction | Section | Number | Township | Number | Range | Number |
| County: Cowley | SE 1/4 NW 1/4 SE 1/4 | 19 | | 33 | | 4 | EW |

Distance and direction from nearest town or city street address of well if located within city?
22725 Cst. Strother Field Industrial Park, Winfield

2 WATER WELL OWNER: **GPP GROUP Inc.**
 RR #, St. Address, Box #: **PO BOX 8648**
 City, State, ZIP Code: **Woodcliff Lake, NJ 07677**
 Board of Agriculture, Division of Water Resources
 Application Number: **GM4**

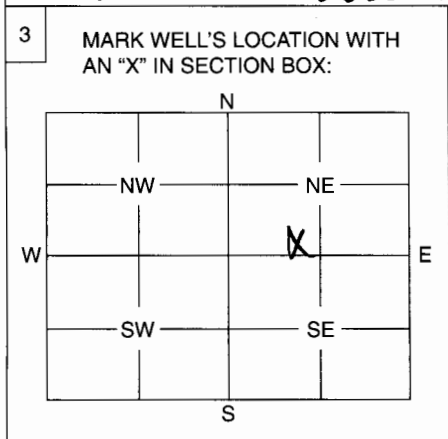

4 DEPTH OF WELL **20** ft.
 WELL'S STATIC WATER LEVEL **1400** ft.
 WELL WAS USED AS:

| | | |
|--------------|----------------------------|---|
| 1 Domestic | 5 Public Water Supply | 9 Dewatering |
| 2 Irrigation | 6 Oil Field Water Supply | <input checked="" type="radio"/> 10 Monitoring Well |
| 3 Feedlot | 7 Domestic (Lawn & Garden) | 11 Injection Well |
| 4 Industrial | 8 Air Conditioning | 12 Other |

Was a chemical / bacteriological sample submitted to Department? Yes No
 If yes, mo/day/yr sample was submitted

Water Well Disinfected: Yes No

5 TYPE OF BLANK CASING USED:

| | | | | |
|--|------------|-------------------|-----------------|-------------------------|
| 1 Steel | 3 RMP (SR) | 5 Wrought | 7 Fiberglass | 9 Other (Specify below) |
| <input checked="" type="radio"/> 2 PVC | 4 ABS | 6 Asbestos-Cement | 8 Concrete Tile | |

Blank casing diameter **2** in. Was casing pulled? Yes No If yes, how much **20** in.
 Casing height above or below land surface

6 GROUT PLUG MATERIAL: 1 Neat cement 2 Cement grout Bentonite 4 Other

Grout Plug Intervals: From **1** ft. to **16.8** ft., From ft. to ft., From to ft.

What is the nearest source of possible contamination:

| | | | |
|--------------------------|-------------------|--|--------------------------|
| 1 Septic tank | 6 Seepage pit | <input checked="" type="radio"/> 11 Fuel storage | 16 Other (specify below) |
| 2 Sewer lines | 7 Pit privy | 12 Fertilizer storage | |
| 3 Watertight sewer lines | 8 Sewage lagoon | 13 Insecticide storage | |
| 4 Lateral lines | 9 Feedyard | 14 Abandoned water well | |
| 5 Cess pool | 10 Livestock pens | 15 Oil well/Gas well | |

Direction from well? How many feet?

| FROM | TO | PLUGGING MATERIALS |
|-------------|-------------|--------------------|
| 0 | 1 | Concrete |
| 1 | 16.8 | Bentonite |
| 16.8 | 20 | Soil |
| | | |
| | | |
| | | |

7 CONTRACTOR'S OR LANDOWNER'S CERTIFICATION: This water well was plugged under my jurisdiction and was completed on (mo/day/year) **1/30-1/31/06** and this record is true to the best of my knowledge and belief. Kansas Water Well Contractor's License No. **216106** This Water Well Record was completed on (mo/day/year) **2/6/06** under the business name of **Larsen & Associates, Inc.** by (signature) **Kelly Mann**

INSTRUCTIONS: Use typewriter or ball point pen. Please press firmly and print clearly. Please fill in blanks, underline or circle the correct answers. Send top three copies to Kansas Department of Health and Environment, Bureau of Water, Geology Section, 1000 SW Jackson St., Ste. 420, Topeka, Kansas 66612-1367. Telephone: 785/296-5522. Send one to Water Well Owner and retain one for your records.