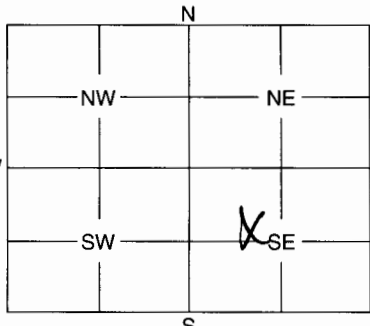


1 LOCATION OF WATER WELL: Fraction Section Number Township Number Range Number  
 County: Cowley SE 1/4 NW 1/4 SE 19 33 4 EW

Distance and direction from nearest town or city street address of well if located within city?  
22725 Cst. Strothor Field Industrial Park, Winfield

2 WATER WELL OWNER: GPP GROUP Inc.  
PO BOX 8648  
 RR #, St. Address, Box #: Woodcliff Lake, NJ 07677 Board of Agriculture, Division of Water Resources  
 City, State, ZIP Code : Woodcliff Lake, NJ 07677 Application Number: 6ML6

3 MARK WELL'S LOCATION WITH AN "X" IN SECTION BOX:  


4 DEPTH OF WELL 22 ft.  
 WELL'S STATIC WATER LEVEL 13.65 ft.  
 WELL WAS USED AS:  
 1 Domestic 2 Irrigation 3 Feedlot 4 Industrial 5 Public Water Supply 6 Oil Field Water Supply 7 Domestic (Lawn & Garden) 8 Air Conditioning 9 Dewatering 10 Monitoring Well 11 Injection Well 12 Other .....

Was a chemical / bacteriological sample submitted to Department? Yes ..... No .....  
 If yes, mo/day/yr sample was submitted .....

Water Well Disinfected: Yes ..... No .....

5 TYPE OF BLANK CASING USED:  
 1 Steel 2 PVC 3 RMP (SR) 4 ABS 5 Wrought 6 Asbestos-Cement 7 Fiberglass 8 Concrete Tile 9 Other (Specify below) .....

Blank casing diameter 2 in. Was casing pulled? Yes X No ..... If yes, how much 19.4 .....

Casing height above or below land surface 0 in. ....

6 GROUT PLUG MATERIAL: 1 Neat cement 2 Cement grout 3 Bentonite 4 Other .....

Grout Plug Intervals: From 1 ft. to 20 ft., From ..... ft. to ..... ft., From ..... to ..... ft.

What is the nearest source of possible contamination:  
 1 Septic tank 2 Sewer lines 3 Watertight sewer lines 4 Lateral lines 5 Cess pool 6 Seepage pit 7 Pit privy 8 Sewage lagoon 9 Feedyard 10 Livestock pens 11 Fuel storage 12 Fertilizer storage 13 Insecticide storage 14 Abandoned water well 15 Oil well/Gas well 16 Other (specify below) .....

Direction from well? ..... How many feet? .....

FROM	TO	PLUGGING MATERIALS
<u>0</u>	<u>1</u>	<u>Concrete</u>
<u>1</u>	<u>20</u>	<u>Bentonite</u>

7 CONTRACTOR'S OR LANDOWNER'S CERTIFICATION: This water well was plugged under my jurisdiction and was completed on (mo/day/year) 1/30-1/31/06 and this record is true to the best of my knowledge and belief. Kansas Water Well Contractor's License No. 957 This Water Well Record was completed on (mo/day/year) 2/6/06 under the business name of Larsen & Associates, Inc. by (signature) Kelly Mann

INSTRUCTIONS: Use typewriter or ball point pen. Please press firmly and print clearly. Please fill in blanks, underline or circle the correct answers. Send top three copies to Kansas Department of Health and Environment, Bureau of Water, Geology Section, 1000 SW Jackson St., Ste. 420, Topeka, Kansas 66612-1367. Telephone: 785/296-5522. Send one to Water Well Owner and retain one for your records.