


1 LOCATION OF WATER WELL: County: COWLEY Fraction: SW 1/4 SW 1/4 NE 1/4 Section Number: 19 Township Number: T 33 S Range Number: R 4 E/W

Distance and direction from nearest town or city street address of well if located within city? STROTHER FIELD INDUSTRIAL PARK

2 WATER WELL OWNER: KCHE RR#, St. Address, Box # MW-7A-86 City, State, ZIP Code: Board of Agriculture, Division of Water Resources Application Number:

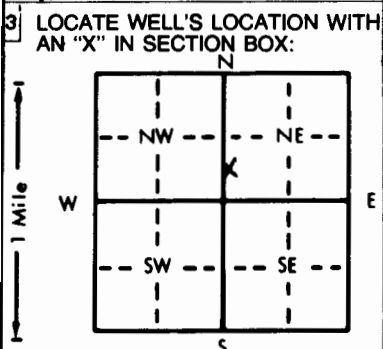

4 DEPTH OF COMPLETED WELL: 37.5 ft. ELEVATION: Depth(s) Groundwater Encountered 1. ft. 2. ft. 3. ft. WELL'S STATIC WATER LEVEL ft. below land surface measured on mo/day/yr Pump test data: Well water was ft. after hours pumping gpm Est. Yield gpm; Well water was ft. after hours pumping gpm Bore Hole Diameter: 6 1/2 in. to 38.5 ft., and in. to ft. WELL WATER TO BE USED AS: 5 Public water supply 8 Air conditioning 11 Injection well 1 Domestic 3 Feedlot 6 Oil field water supply 9 Dewatering 13 Other (Specify below) MONITOR WELL 2 Irrigation 4 Industrial 7 Lawn and garden only 10 Observation well Was a chemical bacteriological sample submitted to Department? Yes No; If yes, mo/day/yr sample was submitted Water Well Disinfected? Yes No

5 TYPE OF BLANK CASING USED: 1 Steel 3 RMP (SR) 5 Wrought iron 8 Concrete tile CASING JOINTS: Glued Clamped 2 PVC 4 ABS 6 Asbestos-Cement 9 Other (specify below) Welded 7 Fiberglass Threaded Blank casing diameter 2 in. to 32.5 ft., Dia in. to ft., Dia in. to ft. Casing height above land surface in., weight lbs./ft. Wall thickness or gauge No. SCHED 40

TYPE OF SCREEN OR PERFORATION MATERIAL: 1 Steel 3 Stainless steel 5 Fiberglass 8 RMP (SR) 10 Asbestos-cement 2 Brass 4 Galvanized steel 6 Concrete tile 9 ABS 11 Other (specify) 12 None used (open hole)

SCREEN OR PERFORATION OPENINGS ARE: 1 Continuous slot 3 Mill slot 5 Gauzed wrapped 8 Saw cut 11 None (open hole) 2 Louvered shutter 4 Key punched 6 Wire wrapped 9 Drilled holes 10 Other (specify) 7 Torch cut

SCREEN-PERFORATED INTERVALS: From 32.5 ft. to 37.5 ft., From ft. to ft. From ft. to ft., From ft. to ft. GRAVEL PACK INTERVALS: From 10 ft. to 37.5 ft., From ft. to ft. From ft. to ft., From ft. to ft.

6 GROUT MATERIAL: 1 Neat cement 2 Cement grout 3 Bentonite 4 Other Grout Intervals: From 0 ft. to 10 ft., From ft. to ft., From ft. to ft.

What is the nearest source of possible contamination: 1 Septic tank 4 Lateral lines 7 Pit privy 10 Livestock pens 14 Abandoned water well 2 Sewer lines 5 Cess pool 8 Sewage lagoon 11 Fuel storage 15 Oil well/Gas well 3 Watertight sewer lines 6 Seepage pit 9 Feedyard 12 Fertilizer storage 16 Other (specify below) 13 Insecticide storage

Direction from well? How many feet?

FROM	TO	LITHOLOGIC LOG	FROM	TO	LITHOLOGIC LOG
0	.5	Topsoil			
.5	3	RED BROWN & GRAY SILTY CLAY trace sand			
3	15	RED BROWN SILTY-SANDY CLAY			
15	21	GRAY-BROWN SILTY-SANDY CLAY			
21	37.5	BROWN FINE SAND			
37.5	38.5	GREEN WEATHERED SHALE			

7 CONTRACTOR'S OR LANDOWNER'S CERTIFICATION: This water well was (1) constructed, (2) reconstructed, or (3) plugged under my jurisdiction and was completed on (mo/day/year) 7/28/86 and this record is true to the best of my knowledge and belief. Kansas Water Well Contractor's License No. This Water Well Record was completed on (mo/day/yr) 8/2/86 under the business name of Ks. Dept. of Health & Environment by (signature) [Signature]

INSTRUCTIONS: Use typewriter or ball point pen. PLEASE PRESS FIRMLY and PRINT clearly. Please fill in blanks, underline or circle the correct answers. Send top three copies to Kansas Department of Health and Environment, Office of Oil Field and Environmental Geology, Regulation and Permitting Section, Topeka, Kansas 66620-7500, Telephone: 913-862-9360. Send one to WATER WELL OWNER and retain one for your records.

OFFICE USE ONLY T R E/W SEC. 1/4 1/4 1/4